KANSAS

FORM 51 10M 12-46 PETROL


Barton County

Section 6 Township 19 Range 15-W

Well No. 1 L. Schegel

Company Stanolind

Ryan Pool

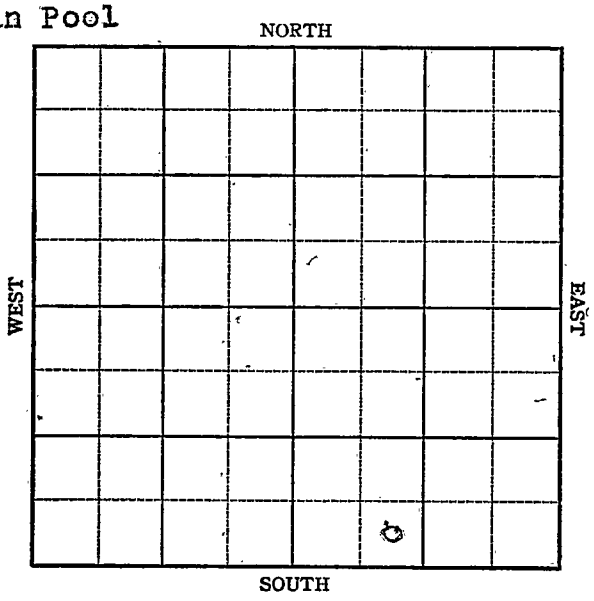

FORM 252-A
5M 12-46 PETROL

KANSAS Barton

Sec. 6 Twp. 19 R. 15-W

Well No. #1 L. Schegel Farm

Stanolind Company

Ryan Pool


____ Ft. from N. Line

330 Ft. from S. Line

____ Ft. from E. Line

990 Ft. from W. Line

SE SW SE

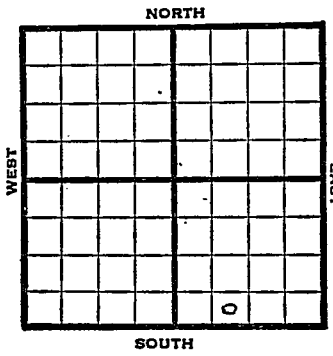

1947	REPORT
	Elev 2008'
7/9	Location
7/16	Drlg. 840'
7/22	Drlg 3090'
7/29	Lansing 3234' Arbuckle 3642-47' TD 5" @ 3639' RUST
8/6	TD 3647' WPB 3645'
8/13	Reagan 3651 TD 3658 Swb 3 bbls oil & 2 W in 8 hrs.
8/20	Reagan 3651' 5" @ 3639' Pump 42 oil + 288 W Pot. Gr. 36 T.D. 3658' Completed.
	COMPLETED

Form 26 200 Bks. 10-46 Petrol

Kansas

Ryan Pool

Map No. _____ Sec. 6 Twp. 19 R. 15W


Well No. 1 L. Schegel

Stanolind Company

FIRST REPORT Contractor

SE SW SE

SECTION PLAT

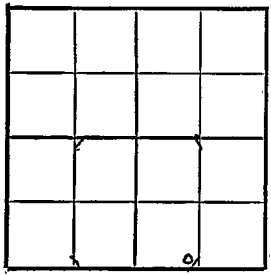

_____ Ft. from N. Line

330 Ft. from S. Line

_____ Ft. from E. Line

990 Ft. from W. Line

Barton County

Location X

Rig up _____

Drilling and Remarks:

RECORD

Cased _____ in., _____ ft.

Sand _____

Gas _____

Oil _____

Total Depth _____

PRODUCTION

1st 24 hrs. Nat. _____

1st 24 hrs. after shot _____

Gas _____ Cu. Ft.

Dry Hole _____

Abandoned _____

Date

JUL 9 1947 19 S. J. LEWIS Scout

Form 26 200 Bks. 10-46 Petrol

Kansas

Ryan Pool

Map No. 82 Sec. 6 Twp. 19 R. 15W

Well No. 1 L. Schegel


Stanolind Company

COMPLETE Contractor

SE SW SE

E 1, 2008'

SECTION PLAT

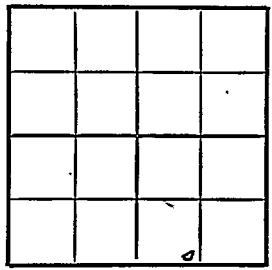

____ Ft. from N. Line

330 Ft. from S. Line

____ Ft. from E. Line

990 Ft. from W. Line

Barton County

Location

Rig up

Drilling and Remarks:

Reagan 3607

3688

Pump 72 bbl

288 W Ost

86 Gr

RECORD

Cased ____ in., ____ ft.

Sand

Gas

Oil

Total Depth 3658'

PRODUCTION

1st 24 hrs. Nat.

1st 24 hrs. after shot

Gas ____ Cu. Ft.

Dry Hole

Abandoned

Date

AUG 20 1947 19

S. J. LEWIS Scout