


Map No. 15 Sec. 6 Twp. 19 R. 15W
 Well No. 1- Morris Farm _____
Palmer Oil Company _____

NORTH

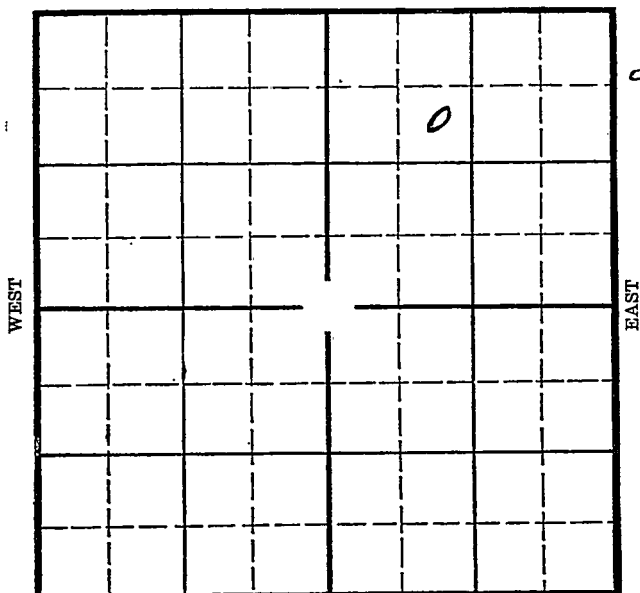

SOUTH

Location _____
 Drilling Remarks _____

Rig Up _____
 Drilling Remarks _____

RECORD

Cased _____ in. _____ ft.
 Sand _____
 Gas _____
 Oil _____
 Total Depth _____

PRODUCTION

1st 24 hrs. Nat. _____
 1st 24 hrs. after shot _____
 Gas _____ cu. ft. _____
 Dry Hole _____
 Abandoned _____

Barton

Map No. KANSAS Sec. 6 Twp. 19 R. 15^W

Well No. 1- Morris Farm
Palmer Oil Company


990 Ft. from N. Line

_____ Ft. from S. Line

_____ Ft. from E. Line

990 Ft. from W. Line

Elev. 1987

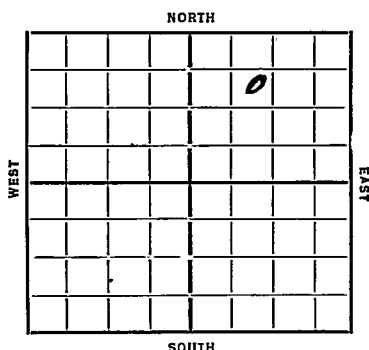

Date

REPORT

1935
6/12 Cellar
6/20 Rig
6/28 R.C.
7/3 20" 200 15" 420
7/11 Relg 780
7/18 12" 1005 C.O.
8/8 Relg 3140 10" 2448
8/15 8" 3223 R.C. 3315
W.R. 8" 3335
8/22 Relg 3433 8" 3413
8/29 H.R.W. 3460 7" 3495
Aug 3535 Reagan Rd 3538
Relg 3609
9/4 Relg 3627
TJ 3670
70 Ft.

ABANDONED

Map No. 82 Sec. 6 Twp. 19 R. 15WWell No. 1-MorrisPalmed Oil Company

Contractor

FIRST REPORTS

SECTION PLAT

990 Ft. from N. Line

Ft. from S. Line

Ft. from E. Line

990 Ft. from W. Line

		0	

Location

Rig up

Drilling and Remarks:

cellar

RECORD

Cased in., ft.

Sand

Gas

Oil

Total Depth

PRODUCTION

1st 24 hrs. Nat.

1st 24 hrs. after shot

Gas Cu. Ft.

Dry Hole

Abandoned

Date

ORVAL MANN SCHRECK

6-12-35

192

Scout

KANSAS

Form 26-1M Bks. 9-28

Map No. 82 Sec. 6 Twp. 19 R. 15WWell No. 1-MorrisPalmer Oil Company

Contractor

ABANDONED

SECTION PLAT

		0	

990 Ft. from N. Line

Ft. from S. Line

Ft. from E. Line

990 Ft. from W. Line

Location

Rig up

Drilling and Remarks:

10 + A

RECORD

Cased in. ft.Sand Sil 3627

Gas

Oil

Total Depth 3670

PRODUCTION

1st 24 hrs. Nat.

1st 24 hrs. after shot

Gas Cu. Ft.

Dry Hole

Abandoned

Date

9-4-35 192 ORVAL MANNSCHRECK Scout