

Ness


KANSAS

Section 6 Township 19 Range 23 W

Well No. # 1 Pfannenstiel

Company Sohio

13

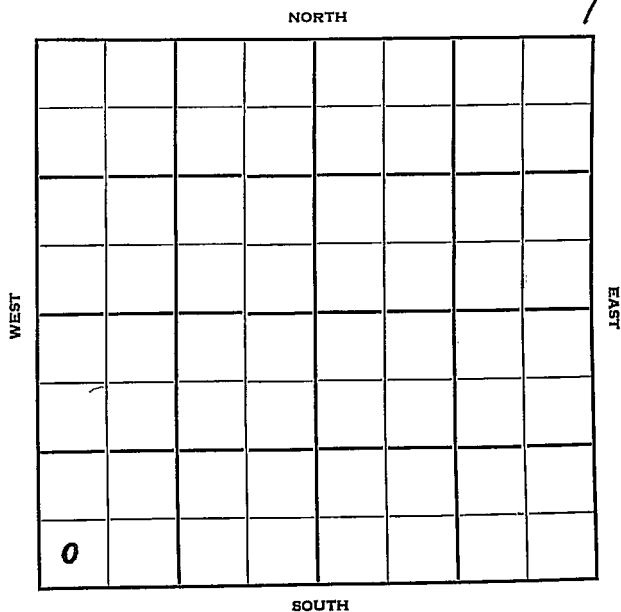

Sec. 6 Twp. 19 R. 23WWell No. #1 Pfannenstiel FarmSohio CompanyArmer - Contr. Contractor


Ft. from N. Line

330' Ft. from S. Line

Ft. from E. Line

330' Ft. from W. Line

SW SW SW

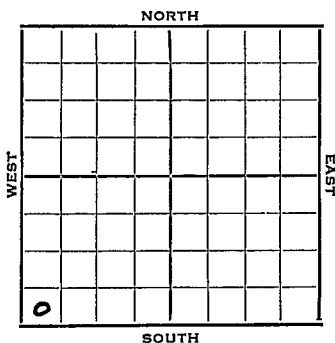

1952 Elev. 2252' REPORT

9/17 Location

9/24 "

10/1 8" @ 199'
Anhy 1515' Topeka 3365'
Heeb 3645'
Drlg.10/8 Lans. 3690
DST 4023-60 open 1 hr. rec. 10' mud.
Miss. 4286 TD 4295
DST 4279-95 open 1 hr. rec. 355'
muddy oil & 5' wtr. 315# setting 5"10/15 CO to 4296, 500A, S/30 go & 10 gwph
DD 4305, B/2 BO & 2 BWPH10/22 Spud 9-26-52
D&A
TD 4315'
8" @ 199
Anhy 1515', Top. 3365', Heeb. 3645',
Lans 3690
DST 4023-60, opn 1 hr., rec. 10' mud
Miss 4286'
TD 4295
DST 4279-95, opn 1 hr., rec. 355'
muddy oil 5' wtr 315#
5" @ 4281
CO to 4296 500A S/30 go 10 gwph
12 hr., DD 4305 B/2 bo 2 bw ph

OVER

County Ness State KansasSec. 6 (Blk.) 19 (Sur.) 23W Map No.Operator SchieWell No. 1 Farm PfannenstielElev. Location SW SW SW

0									

330 Ft. From S Line SW330 Ft. From W Line Quarter1st. Report 2661 2 1 'd3S,

Completion

Remarks

Armer - Contr.

Spudding Date

Drlg. Data

Location

J. G. McGEHEE

J. G. McGEHEE

(Information Brought Forward)

1952

10/22

12 hrs. DD 4315 wtr & SSO
20/4270-75 B/2 bw & SSO 4 hrs.
D&A

ABANDONED