

Section 7 Township 19 Range 12 W

Well No. # 1 Bryant

Company Alpine Oil & Royalty

NORTH

4

0							

SOUTH

WEST

EAST

Barton KANSAS

Sec. 7 Twp. 19 R 12 W N

Well No. # 1 Bryant Farm

Alpine Oil & Royalty Company

Quaker Contractor

Wildcat


990 Ft. from N. Line

 Ft. from S. Line

 Ft. from E. Line

330 Ft. from W. Line

SW NW NW

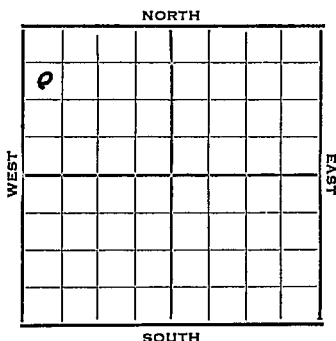

1952

Elev. 1882'

R E P O R T

4/2

Spud 3-31-52
8" @ 253' WOC

4/9

Heeb. 3082 Br Li 3187
Lans. 3201

DST 3203-76 1/2 hr. 15' M

470# DST 3325-96

4/16

Spud 3-31-52

D&A TD 3504 8" @ 253

Heeb. 3082 Br Li 3187

Lans. 3201


DST 3203-76 open 1/2 hr. rec. 15' mud

DST 3325-96 open 1/2 hr. rec. 20' mud

Cong. 3439 Arb. 3464

TD 3504' D&A

ABANDONED

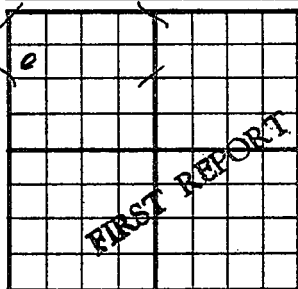County Barton State KansasSec. 7 (Bik. Twp.) 19 (Sur. Rge.) 12W Map No.Operator Alpine Oil & RoyaltyWell No. 1 Farm BryantElev. Location SW NW NW990 Ft. From N Line NW530 Ft. From W Line Quarter1st. Report APR 2 1952


Completion

Remarks

Quaker - Contr.Spudding Date 3-31-52Drlg. Data Wildcat8" @ 253 W.O.C.

J. G. McGEHEE

County Barton State Kansas
 Sec. 7 (Blk. 19) (Sur. 12W) Map No. _____
 Operator Alpine Oil & Royalty
 Well No. 1 Farm Bryant
 Elev. 1882 Location SW NW NW

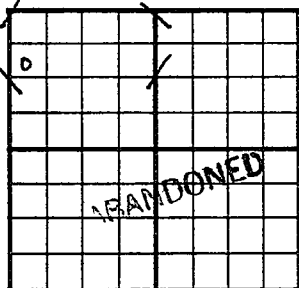

990 Ft. From N Line NW
330 Ft. From W Line Quarter
 1st. Report _____
 Completion APR 16 1952
 Remarks Wildcat
Quaker Drlg. - Contr.
 Spudding Date 3-31-52

Drlg. Data D & A TD 3504

8" @ 253 Heeb. 3082 Br. line 3187

Lans. 3201 DST 3203-76 open $\frac{1}{2}$ hr.

Rec. 15' mud DST 3325-96 open $\frac{1}{2}$ hr.

Rec. 20' mud Cong. 3439 Arb. 3464

TD 3504

D & A

J. G. McGEHEE