


Section 7 Township 19 Range 11-W

Well No. #1 Thul

Company Skelly Oil

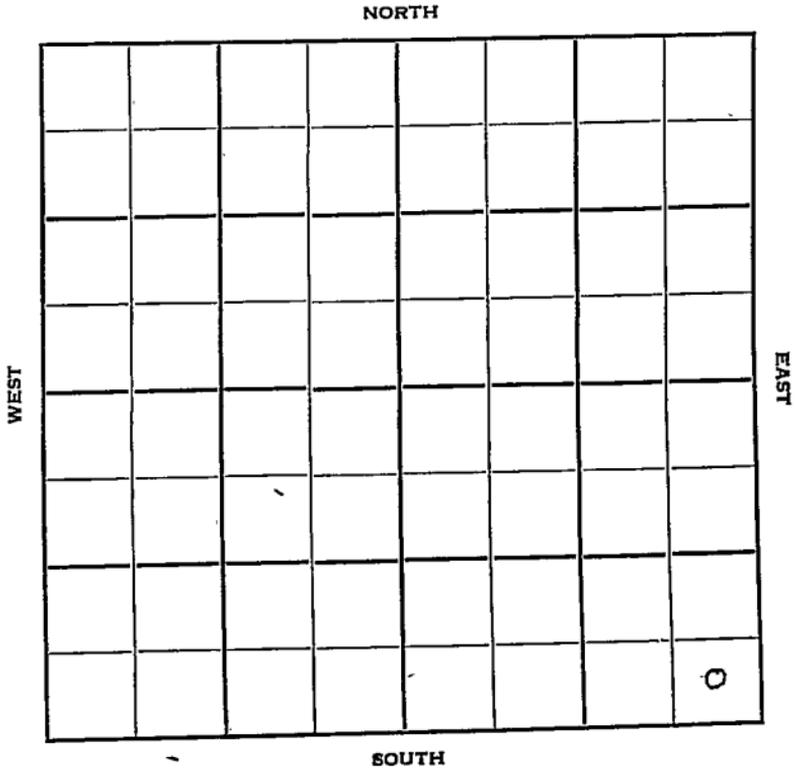

Sec. 7 Twp. _____ R. _____

Well No. #1 Thul Farm _____

Skelly Oil Company _____

Contractor _____
Hammeke Pool


_____ Ft. from N. Line

330' _____ Ft. from S. Line

330' _____ Ft. from E. Line

_____ Ft. from W. Line

SE SE SE

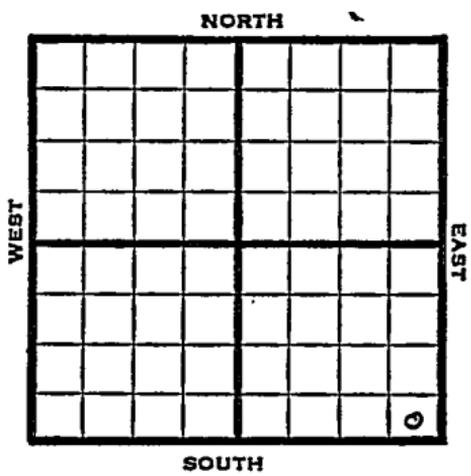

1950

Elev 1773 REPORT

6/14

Spud 6-11-50
Anhy 550'
Drlg. 560'

7/19

Anhy 550
8" @ 540
Lans 3069
DST 3072-3103, oplhr rec 120' wtr
cur mud
gas stain 3142-44 3153-77 3163-71
DST 3142-71, opn 1 hrrec 1020' oil
Cong 3327 Arb 3382-90
5" @ 3384
47/3266-74
500 acid
24/3239-45
1000 acid
S/2 1/2 bo 5 bw 6 hr
Sq off 3239-45
35/3227-34
500 acid
1500 acid
test 3 bwph
PB 3219
35/3208-15
500 acid
test 10 gw 3 hr
PB 3189
24/3152-56, 23/3140-41
S/25 bo 1 bw 3 hr
100 0 acid Comp 309 bopd 15% wtr
Completed **COMPLETED**

Map No. _____ Sec. 7 Twp. 19 R. 11WWell No. 1 ThulSkelly Oil Company

Contractor

SE SE SE

SECTION PLAT

_____ Ft. from N. Line

330 Ft. from S. Line330 Ft. from E. Line

_____ Ft. from W. Line



Barton County

Location _____

Rig up _____

Drilling and Remarks:

Spud 6-11-50

Anhy 550

drlg. 560

RECORD

Cased _____ in., _____ ft.

Sand _____

Gas _____

Oil _____

Total Depth _____

PRODUCTION

1st 24 hrs. Nat. _____

1st 24 hrs. after shot _____

Gas _____ Cu. Ft.

Dry Hole _____

Abandoned _____

Date

JUN 14 1950 19J. E. TYRA Scout

Scout Cards	
Land Small Map	
Land Wall Map	
Tracings	
France Map	
Pierce Map	
Misc.	

JUN 15 1950

Map No. _____ Sec. 7 Twp. 19 R. 11WWell No. 1st ThulSkelly Oil Company

Contractor


SE SE SE

E1. 1773
SECTION PLAT

_____ Ft. from N. Line

330 Ft. from S. Line330 Ft. from E. Line

_____ Ft. from W. Line

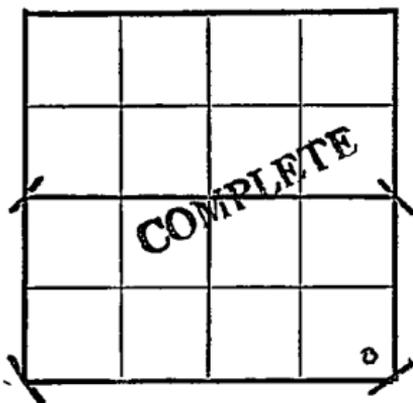

Barton County

Location _____

Rig up _____

Drilling and Remarks:

Anhy 550

8" @ 540

Lans. 3069

DST 3072-3103

open 1 hr.

Rec. 120' water
cut mud

RECORD

Cased _____ in., _____ ft.

Sand _____

Gas _____

Oil _____

Total Depth 3390

PRODUCTION

1st 24 hrs. Nat. _____

1st 24 hrs. after shot _____

Gas _____ Cu. Ft.

Dry Hole _____

Abandoned _____

Date

JUL 19 1950 19J. E. TYRA Scout

gas stain 3142-44 3153-77 3163-71

DST 3142-71

open 1 hr.

Rec. 1020: oil

Cong. 3327

Arb. 3382-9

5" @ 3384

47 / 3266-74

500 acid

24 / 3239-45

1000 acid

S / 2 1/2 bo 5 bw 6 hr.

Sg. off 3239-45

35 / 3227-34

500 acid

1500 acid

test 3 bwph

PB 3219

35 / 3208-15

500 acid

test 10 gw 3 hr.

PB 3189

24 / 3152-56

23 / 3140-41

S / 25 bo 1 bw 3 hr.

1000 acid

Comp. 309 bopd 15% water

7W

Scout Cards _____

Land Small Map _____

Land Wall Map _____

Tracings _____

France Map _____

Pierce Map _____

Misc. _____

AUG 11 1961