

# KANSAS


Form 51-5M-7-40-Palace

Rice

Section 7 Township 19 Range 10-W

Well No. #1 Karber

Company C. L. Carlock et al

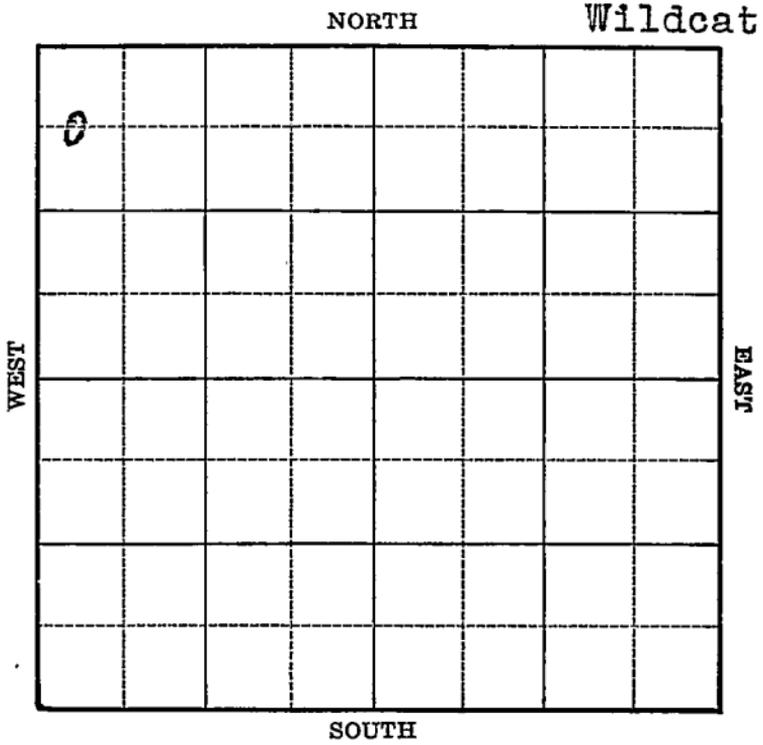

Sec. 7 Twp. 19 R. 10-W

Well No. #1 Karber Farm \_\_\_\_\_

C. L. Carlock et al Company \_\_\_\_\_

(Wildcat)


660 Ft. from N. Line

\_\_\_\_\_ Ft. from S. Line

\_\_\_\_\_ Ft. from E. Line

330 Ft. from W. Line

Elev. 1776

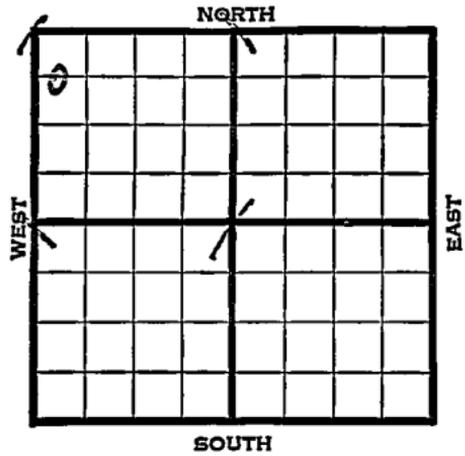

1940	REPORT
9/18	Drlg. 165'
9/26	8" - 169' Anhy 540'
	Ft. Riley 1490' Drlg. 2180'
10/3	Lansing 3027' SSO 3262-63'
	BKC 3290' Arb. <del>3348</del> <sup>3340</sup> 1/2-46' Sat.
	Run pipe.
10/10	Arb. 3349' (Corrected)
	5" - 3349' T.D. 3354' RUST.
10/17	3000 acid. Pump 380 bbls. 7 3/4
	hours. 34. gravity.
10/24	" " " "
10/31	" " " "
11/7	" " " "
11/13	Arb. 3344'
	5" - 3344'
	T.D. 3350'
	3000 acid.
	Potential 280 bbls., pump.
	<b>COMPLETED</b>

Map No. 46 Sec. 7 Twp. 19 R. LOWWell No. 1 KarberC. L. Carlock etal Company

Contractor

## FIRST REPORT

C W L NW NW

660 Ft. from N. Line

\_\_\_\_\_ Ft. from S. Line

\_\_\_\_\_ Ft. from E. Line

330 Ft. from W. Line

## SECTION PLAT


WILDCAT

Location \_\_\_\_\_

Rig up \_\_\_\_\_

Drilling and Remarks:

Drig. 165

## RECORD

Cased \_\_\_\_\_ in., \_\_\_\_\_ ft.

Sand \_\_\_\_\_

Gas \_\_\_\_\_

Oil \_\_\_\_\_

Total Depth \_\_\_\_\_

## PRODUCTION

1st 24 hrs. Nat. \_\_\_\_\_

1st 24 hrs. after shot \_\_\_\_\_

Gas \_\_\_\_\_ Cu. Ft.

Dry Hole \_\_\_\_\_

Abandoned \_\_\_\_\_

Date

SEP 18 1940 19

S. J. LEWIS Scout

Map No. 46 Sec. 7 Twp. 19 R. 10W

Well No. 1 Karber

C. L. Carlock etal Company

Contractor

**COMPLETED**

C W L NW NW

660 Ft. from N. Line

\_\_\_\_\_ Ft. from S. Line

\_\_\_\_\_ Ft. from E. Line

330 Ft. from W. Line

**SECTION PLAT**

0			

WILDCAT

Location \_\_\_\_\_

Rig up \_\_\_\_\_

Drilling and Remarks:

*Cu & 3344*  
*5" @ 3344*  
*3000 acid*  
*Pump 2 TD P.K.*

**RECORD**

Cased \_\_\_\_\_ in., \_\_\_\_\_ ft.

Sand \_\_\_\_\_

Gas \_\_\_\_\_

Oil \_\_\_\_\_

Total Depth 3350

**PRODUCTION**

1st 24 hrs. Nat. \_\_\_\_\_

1st 24 hrs. after shot \_\_\_\_\_

Gas \_\_\_\_\_ Cu. Ft.

Dry Hole \_\_\_\_\_

Abandoned \_\_\_\_\_

Date

NOV 13 1940 19 S. J. LEWIS Scout