


Rice

Section 7 Township 19 Range 10W

Well No. #1 Manke

Company Graybol & Smith

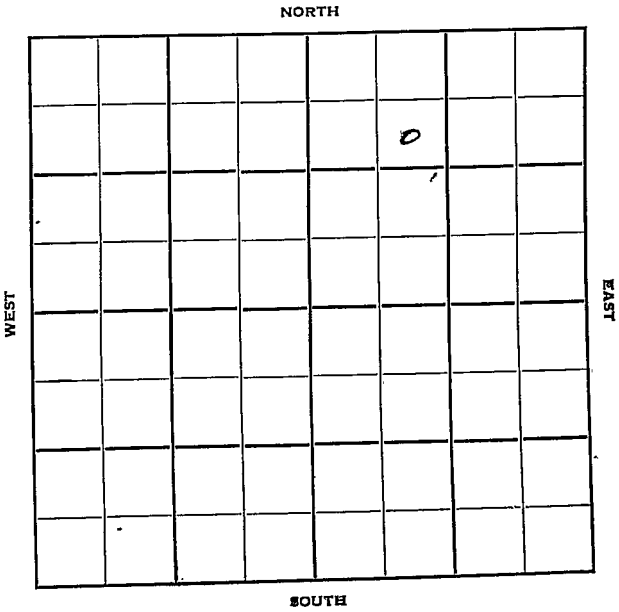

Sec. 7 Twp. 19 R. 10W

Well No. #1 Manke Farm

Graybol & Smith Company

Graybol Contractor  
Wildcat


990 Ft. from N. Line

Ft. from S. Line

Ft. from E. Line

990 Ft. from W. Line

SE NW NE

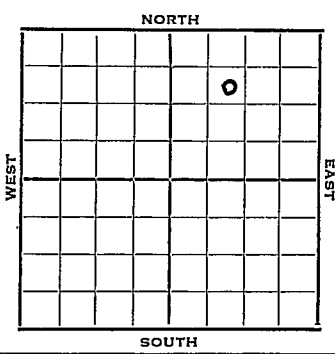

1953 Elev. 1770' REPORT

3/18 Location

3/26 8" @ 191  
Anhy 515  
Drlg. 1740'

4/2 Top 2615 Heeb 2882 Br li 3001  
Lans 3021  
DST 3025-50, 50 mins, 50' GCM 140#  
DST 3093-3105, 40 mins, 20' SOCM  
220#  
Drlg. 3306'

4/8 Spud 3-21-53 D & A TD 3384'  
8" @ 191 Anhy 515 Top. 2615'  
Heeb 2882 Br line 3001 Lans 3021  
DST 3025-50 open 50 min rec 50' GCM  
140#  
DST 3093-3105 open 40 min rec 20'  
SOCM 220# Cong. 3320' Ch. Cong.  
3344' TD 3384 D & A

**ABANDONED**



