

Sec. 7 Twp. 19 R. 10W

Well No. #1 Musenberg Farm

E. Adair et al Company

Wildcat


Ft. from N. Line

330 Ft. from S. Line

Ft. from E. Line

990 Ft. from W. Line

SE SW SE

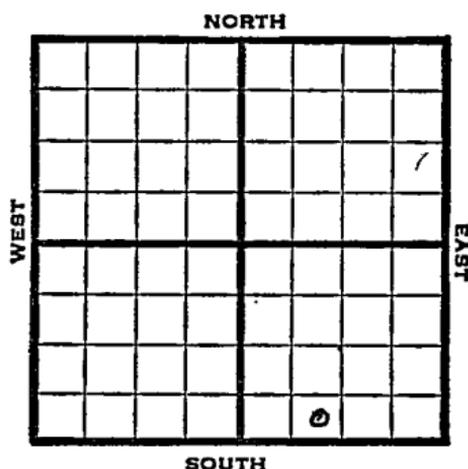

1947

Elev.

REPORT

11/19

Location

11/25

8" @ 272'
WOC

12/3

Ft. Riley 1740'
Topkea 2900'
Drlg. 3038'

12/10

Arbuckle 3346-52' TD
5" @ 3347'
RUST

12/17

Arbuckle 3346'
5" @ 3347'
TD 3365'

ABANDONED

Map No. _____ Sec. 7 Twp. 19 R. 10W

Well No. 1 Musenberg

E. Adair etal. Company

FIRST REPORT Contractor

SE SW SE


SECTION PLAT

_____ Ft. from N. Line

330 Ft. from S. Line

_____ Ft. from E. Line

990 Ft. from W. Line

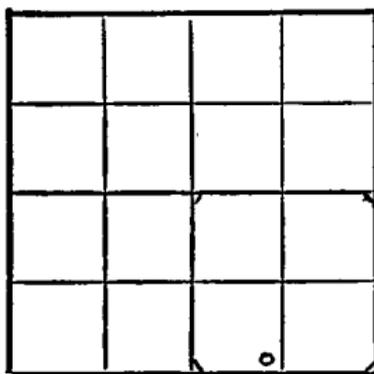

Rice County

Location X

Rig up _____

Drilling and Remarks:

RECORD

Cased _____ in., _____ ft.

Sand _____

Gas _____

Oil _____

Total Depth _____

PRODUCTION

1st 24 hrs. Nat. _____

1st 24 hrs. after shot _____

Gas _____ Cu. Ft.

Dry Hole _____

Abandoned _____

Date

NOV 19 1947

S. J. LEWIS Scout

