

McPherson


FORM 51

KANSAS

Section 7 Township 19 Range 2W

Well No. #1 Smith

Company Geo. Hess

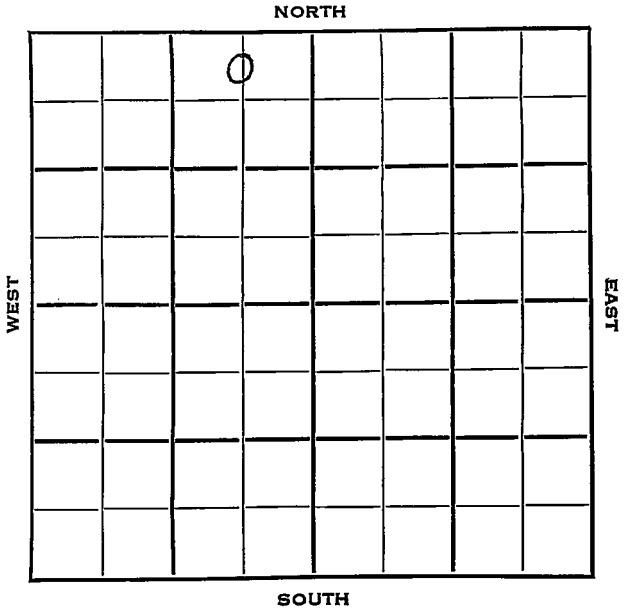

McPherson

SEC.	TWP.	R.
7	19	2W

WELL NO.

COMPANY

#1 Smith

FARM

Geo. Hess.

CONTRACTOR

Mallard Drlg.

Chindberg Pool

330

Ft. from N. Line


Ft. from S. Line

660

Ft. from E. Line

Ft. from W. Line

C N L N E N W

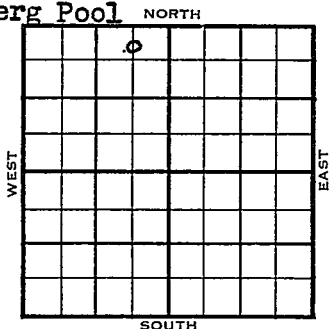

	ELEVATION	REPORT
1953	1553'	

12/22

M I R

1954

1/6

8" @ 158'

Miss 2985'

RTD 2995'

5" @ 2989'

1/13

DD 3000'

S/7 bopd + 700,000 gas, 200A, Hyd

1/20

Spud 12-24-53 Oil well TD 3000'

8" @ 158 Miss 2985 TD 2995


5" @ 2989 DD 3000 S/7 BOPD

700,000 gas 200 A Hydro

S/5 BOPH

Comp. 50 BOPD

COMPLETED

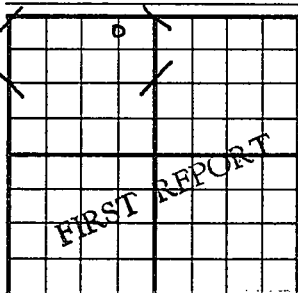County McPherson State KansasSec. 7 (Blk.) 19 (Sur.) 2W Map No.Operator Geo. HessWell No. 1 Farm SmithElev. Location C N L NE NW330 Ft. From N Line NW660 Ft. From E Line Quarter1st. Report DEC 22 1953


Completion

Remarks

Mallard Drlg. - Contr.

Spudding Date

Drlg. Data Chindberg PoolM I R

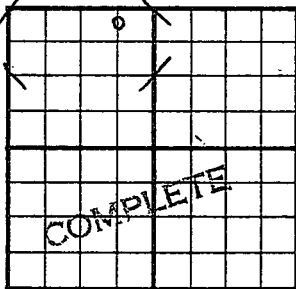County McPherson State KansasSec. 7 (Blk.) 19 (Sur.) 2W Map No.Operator Geo. HessWell No. 1 Farm SmithElev. 1553 Location C N L NE NW330 Ft. From N Line NW660 Ft. From E Line Quarter1st. ReportCompletion JAN 20 1954Remarks Chindberg PoolMallard Drlg. - Contr.Spudding Date 12-24-53Drlg. Data Oil well TD 30008" @ 158 Miss. 2985 TD 29955" @ 2989 DD 3000 S/ 7 bopd700,000 gas 200 A Hydro. S/ 5 bophComp. 50 bopd