

McPherson

KANSAS

SECTION 7 TOWNSHIP 19S RANGE 2W

WELL NO. #1 Hill


COMPANY George Hess

NORTH

^{5/2}
C SW NW

WEST

EAST

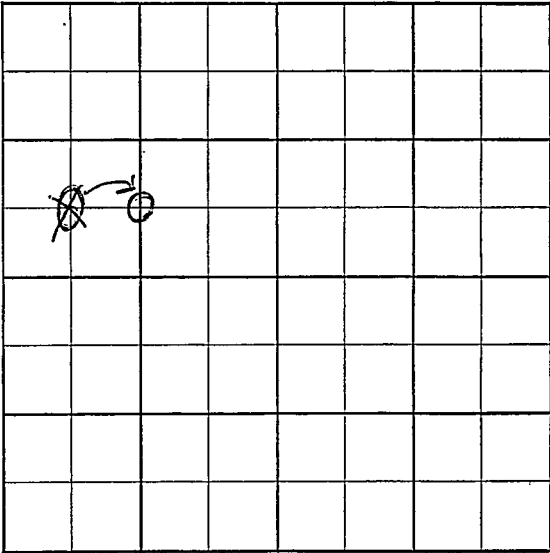

SOUTH

S-513-B

41

County McPherson Elev. _____

Sec. 7 Twp. 19 Rge. 2W

Company George Hess

Farm Name Hill No. 1

TOPS	DEPTH	LOG	DATUM
Anh.			
Tp.			
H.			
Tr.			
Dg.			
B.L.			
L.			
K.C.			
B.K.C.			
Ce.			
C.			
M.			
M.			
K.			
Mz.			
Mq.			
V.			
S.			
S.			
A.			
R.			
Pf.			
G.			
T.D.			

Loc. in Sec. _____


C SW NW

Geol. _____

Contr. _____

Mallard tools

Pool _____

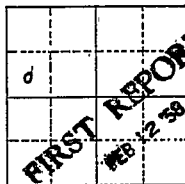

Date Comm. _____

MIRT

Co.

Lsg.

No.

Sec.

T.

R.

K

Co.

Farm Name Hill No. 1

TOPS	DEPTH	LOG	DATUM
Anh.			
Tp.			
H.			
Tr.			
Dg.			
B.L.			
L.			
K.C.	2347		
B.K.C.			
Ce.			
C.			
M.	2997		
M.			
K.			
Mz.			
Mq.			
Vr.			
S.			
S.			
A.			
R.			
Pf.			
G.			
T.D.	3012		

Loc. in Sec. 6 SW NW 1/4
Q 2 1/2 mi

Geo|_____

Contr. _____

Mallard tools

Pool _____

Mc PERSON

	MAP 12 58
a	
COMPLETE	

Date Comm. 2-11-58

MIRT FEB 19 '58 8" 185/125 5" 3000

FEB 26 58 CO NO 3058 # 590.160

g.w. 4 hr PB 23 65 X 50/2351-61

500 Acid MAR 5 53 Tested 2030

+ 20 Bwpd pop MAR 12 58 * BOC/KTOP

$$20 \text{ BQpd} + 20 \text{ BWpd}$$

(icc, top)

45.

No.

Sec.

T.

R.