


Section 7 Township 19 Range 11 W

Well No. #1 Newforth

Company Branine & Leben Oil

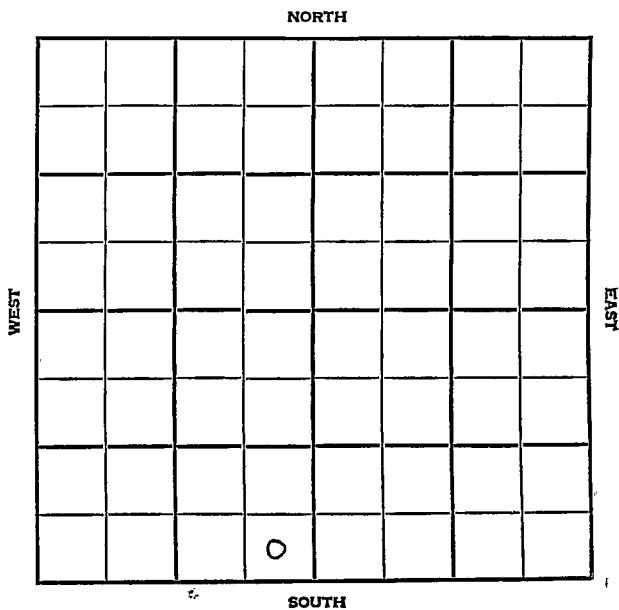

# HOT FILE

Barton

KANSAS

SEC.	TWP.	R.
7	19	14 W

WELL NO. # 1 Newforth FARM

COMPANY Branine & Leben Oil

CONTRACTOR Co. tools

Wildcat

\_\_\_\_\_ Ft. from N. Line

\_\_\_\_\_ Ft. from S. Line

\_\_\_\_\_ Ft. from E. Line

\_\_\_\_\_ Ft. from W. Line

SE SE SW

1/2 Mile - SDX Use

	ELEVATION	REPORT
1955	1928	

8/24  
 Comm. 8-18-55  
 8" @ 905/300  
 Drlg. 2241'  
 Anhy. 889'

8/31  
 Comm 8-18-55  
 Anh 889  
 H 3166  
 B1 3246  
 L 3256  
 C 3504  
 A 3581  
 TD 3586  
 8" @ 205 w/300  
 DST 3580-86 open 1 hr  
 Rec 780' sw BHP 1070# 15" no log  
 D & A

**ABANDONED**

County Barton Elev. \_\_\_\_\_  
 Sec. 7- Twp. 19 Rge. 11W  
 Company Branine & Lebon Oil  
 Farm Name Newforth No. 1

TOPS	DEPTH	LOG	DATUM	Loc. in Sec.
Anh.	<u>889</u>			<u>SE SE SW</u>
Tr.				
H.				
Dg.				
Bl.				
L.				Geol. _____
K.C.				Contr. _____
B.K.C.				
Ce.				<u>Co. tools</u>
C.				Pool _____
M.				
M.				<u>Wildcat</u>
K.				
Mz.				
Mq.				
V.				
S.				
S.				
A.				
R.				
Pe.				
G.				
T.D.				

AUG 24 55  
**FIRST REPORT**  
1/2 mile  
0

Date Comm. 8-18-55  
8" @ 905/300 drlg. 2247

IP

Co. Lse. No. Sec. T. R.

County Barton Elev. 1928  
 Sec. 7 Twp. 19 Rge. 14W  
 Company Branine & Leben Oil  
 FarmName Newforth No. 1

TOPS	DEPTH	LOG	DATUM	Loc. in Sec.
Anh.	<u>889</u>			<u>SE SE SW</u>
TP.				
H.	<u>3166</u>		<u>1238</u>	
Tr.				
Dg.				
Bl.	<u>3246</u>		<u>1318</u>	
L.	<u>3256</u>		<u>1328</u>	
K.C.				Geol.
B.K.C.				Contr.
Ce.				
C.	<u>3504</u>		<u>1576</u>	<u>Co. tools</u>
M.				
M.				Pool
K.				<u>W. C.</u>
Mz.				
Me.				
V.				
S.				
S.				
A.	<u>3581</u>		<u>1653</u>	<b>ABANDONED</b>
R.				
PE.				
G.				
TD.	<u>3586</u>			

Date Comm. 8/18/55 AUG. 31-1955  
8" 205 w/300 DST 3580-86 open 1 hr  
Rec. 780' SW BHP 1070# 15" no log  
D & A

Co.  
Lse.  
No.  
Sec.  
T.  
R.