


Form 26—200 Bks.—1-40—Palace **KANSAS** Rice
Map No. 49 Sec. 35 Twp. 19 R. 8W
Well No. 1 Brubaker
Atlantic - Sinclair Prairie
Company
Contractor

FIRST REPORT

SECTION PLAT

C $W\frac{1}{2}$ SE
Ft. from N. Line
1420 Ft. from S. Line
Ft. from E. Line
660 Ft. from W. Line

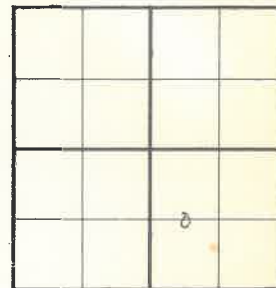

LYONS GAS POOL

Location	RECORD
Rig up	Cased in., ft.
Drilling and Remarks:	Sand
231 Lost Circulation	Gas
	Oil
	Total Depth
	PRODUCTION
	1st 24 hrs. Nat.
	1st 24 hrs. after shot
	Gas Cu. Ft.
	Dry Hole
	Abandoned


Date
OCT 2 1940
19 S. J. LEWIS Scout

Form 26—200 Bks.—1-40—Palace **KANSAS** Rice
Map No. 49 Sec. 35 Twp. 19 R. 8W
Well No. 1 Brubaker
Atlantic & Sinclair Prairie
Company
Contractor

COMPLETED

SECTION PLAT

C $W\frac{1}{2}$ SE
Ft. from N. Line
1420 Ft. from S. Line
Ft. from E. Line
660 Ft. from W. Line

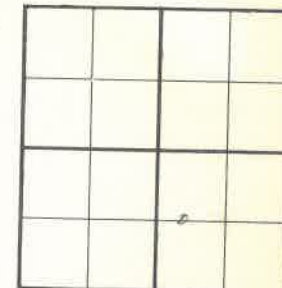


LYONS GAS POOL

Location	RECORD
Rig up	Cased in., ft.
Drilling and Remarks:	Sand
At 8294	Gas
5" @ 8305	Oil
22 shots to 3250-68	Total Depth 3305
24 " 3294-98	PRODUCTION
8,877,000 Gas	1st 24 hrs. Nat.
	1st 24 hrs. after shot
	Gas Cu. Ft.
	Dry Hole
	Abandoned

Date
NOV 6 1940 19 S. J. LEWIS Scout

FORM 252-A 5M 7-40 PETROL **KANSAS** Rice
Sec. 35 Twp. 19 R. 8-W
Well No. #1 Brubaker
Atlantic - Sinclair-Prairie
Farm
Company
(Lyons Gas Pool)

Ft. from N. Line
1420 Ft. from S. Line
Ft. from E. Line
660 Ft. from W. Line

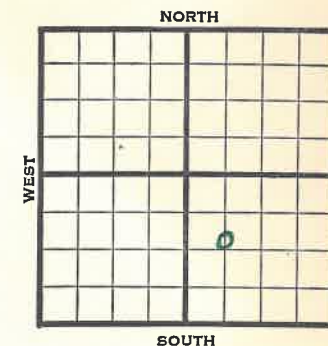

Elev. 1709

1940	REPORT
10/2	231' lost circulation.
10/10	10" - 263' Drlg. 1425'
10/17	Lans. 2845' Simp. 3252' Drlg. 3259'
10/24	Arb. 3294' 5" - 3305' T.D. 96 shots 3250-98' 2-7/10 M gas show water.
10/31	" "
11/6	Arb. 3294' 5" - 3305' T.D. 3305' 72 shots 3250-68' 24 shots 3294-98' 8,877,000 cu. ft. gas.

COMPLETED

KANSAS Rice
Form 51—5M—7-40—Palace
Section 35 Township 19 Range 8-W
Well No. #1 Brubaker
Company Atlantic-Sinclair-Prairie
Lyons Gas Pool

