

Map No. 49 Sec. 35 Twp. 19 R. 8W

Well No. 1 Schmidt  
 M. B. Blake Company  
 Contractor

**FIRST REPORT**  
 C W L SE SE  
 \_\_\_\_\_ Ft. from N. Line  
660 Ft. from S. Line  
810 Ft. from E. Line  
 \_\_\_\_\_ Ft. from W. Line  
 LYONS GAS POOL




Location	RECORD	
	Cased _____ in., _____ ft.	
Rig up _____	Sand _____	
Drilling and Remarks:	Gas _____	
Material	Oil _____	
	Total Depth _____	
	PRODUCTION	
	1st 24 hrs. Nat. _____	
	1st 24 hrs. after shot _____	
	Gas _____ Cu. Ft.	
	Dry Hole _____	
	Abandoned _____	

Date MAY 22 1940 S. J. LEWIS Scout

Map No. 49 Sec. 35 Twp. 19 R. 8W

Well No. 1 Schmidt  
 M. B. Blake Company  
 Contractor

**COMPLETED**  
 C W L SE SE  
 \_\_\_\_\_ Ft. from N. Line  
660 Ft. from S. Line  
810 Ft. from E. Line  
 \_\_\_\_\_ Ft. from W. Line  
 LYONS GAS POOL

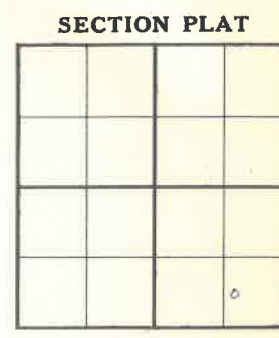

Location	RECORD	
	Cased _____ in., _____ ft.	
Rig up _____	Sand _____	
Drilling and Remarks:	Gas _____	
<i>Arb. 3275</i>	Oil _____	
<i>5" @ 3279</i>	Total Depth <u>3305</u>	
	PRODUCTION	
	1st 24 hrs. Nat. _____	
	1st 24 hrs. after shot _____	
	Gas _____ Cu. Ft.	
	Dry Hole _____	
	Abandoned _____	


Date JUL 2 1940 S. J. LEWIS Scout

Sec. 35 Twp. 19 R. 8-W

Well No. #1 Schmidt Farm  
 M. B. Blake Company

(Lyons Gas Pool)

\_\_\_\_\_ Ft. from N. Line  
660 Ft. from S. Line  
810 Ft. from E. Line  
 \_\_\_\_\_ Ft. from W. Line  
**Elev. 1725**

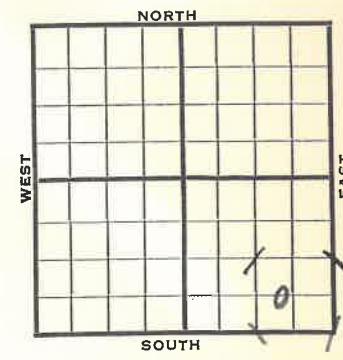

Date	REPORT
1940	
5/22	Material.
5/29	8" - 215' WOC.
6/6	Drlg. 2980'
6/13	Lansing 2850' Cong. 3169' Arb. 3275' T.D. 3305'
	S. Gas 3280-98' 5" - 3279'
	RUST.
6/20	SD 3305'
6/27	Est. 10 M gas. 997# R.P.
7/2	Arb. 3275' 5" - 3279' T.D. 3305' 8-3/10 M gas.
	<b>COMPLETED</b>

Section 35 Township 19 Range 8-W

Well No. #1 Schmidt  
 Company M. B. Blake

