


Section 8 Township 19 Range 12W

Well No. #2 Neeland

Company Westgate-Greenland

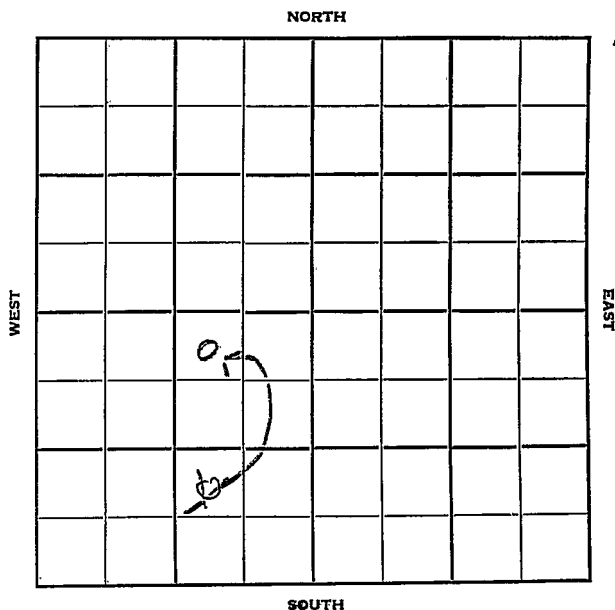

Sec. 8 Twp. 19 R. 12W

Well No. #2 Neeland Farm

Westgate-Greenland Company

Jackson Contractor


330 Ft. from N. Line

~~990~~ Ft. from S. Line

990 Ft. from E. Line

_____ Ft. from W. Line

~~NW~~ ~~SE~~ ~~SW~~
NE

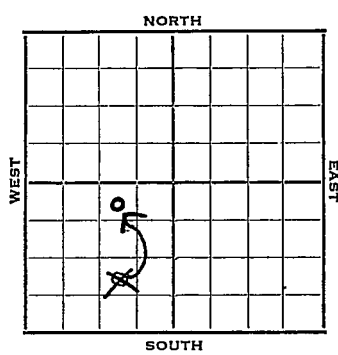

1952 Elev. 1834 REPORT

6/25 MIR
7/2 8" @ 200
Anhy 955
Twist off 2618'
7/9 Skid rig 20' West
Spud 7-7-52
8" @ 200
Drlg. 1498'
7/16 Spud 6-24-52
D&A TD 3431
8" @ 200
Anhy 955 Twist off @ 2618
Skid 20' west Spud 7-4-52 8" @ 200
Anhy 960 Heeb. 3023 Tor. 3028
Br Lime 3132 KC 3147
DST 3151-79 opn 1/2 hr. Rec. 8' mud
DST 3182-3228 opn 1/2 hr. Rec. 10' mud
BKC 3386 Cong. 3394 Arb. 3411
TD 3431 D&A

ABANDONED

Map No. _____ Sec. 8 Twp. 19 R. 12W

Well No. 2 Neeland

Westgate-Greenland Company

CORRECTION

Contractor

NW NE SW

SECTION PLAT

330 Ft. from N. Line

_____ Ft. from S. Line

990 Ft. from E. Line

_____ Ft. from W. Line

	0		

Barton County

Location _____

Rig up _____

Drilling and Remarks:

Reported
NW SE SW

RECORD

Cased _____ in., _____ ft.

Sand _____

Gas _____

Oil _____

Total Depth _____

PRODUCTION

1st 24 hrs. Nat. _____

1st 24 hrs. after shot _____

Gas _____ Cu. Ft.

Dry Hole _____

Abandoned _____

Date

JUN 25 1952 19

J. G. McGEHEE

Scout

