

Barton

KANSAS

Sec. 8 Twp. 19 R. 11 W

Well No. # 1 Ahrens Farm

Adair Company

Adair Contractor

Hammeke


Ft. from N. Line

330 Ft. from S. Line

Ft. from E. Line

330 Ft. from W. Line

SW SW SE

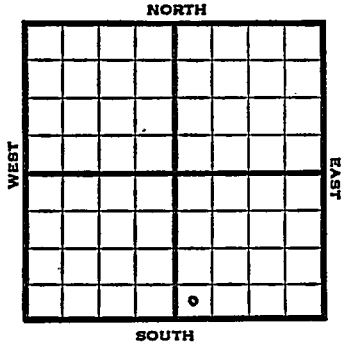

1951

Elev. 1774' REPORT

2/21

Spud 2-17-51
8" @ 236'
Drlg 1600'

3/21

Spud 2-17-51
D&A TD 3391
8" @ 236'
Anhy 575'
KC 3071
DST 3171-81 opn 1/2 hr
Rec. 35' ocm
Cong. 3355' Arb. 3388-91
5" @ 3391
24/3332-40 24/3240-48 24/3204-12
water SP 3190
24/3156-64 24/3174-82 SO
1000 A S/10 bwph D&A

ABANDONED

FEB 23 1951

Scout Cards 777

Land Small Map

Land Wall Map 5

Tracings

France Map

Pieces Map

Misc.

Orig. Data

MAR 23 1957

Scout Cards *OK*

Land Small Map

Land Wall Map *(2)*

Tracings

France Map

Pierce Map

Misc.