


Section 8 Township 19 Range 11-W

Well No. #1 Birzer

Company J C Dozier

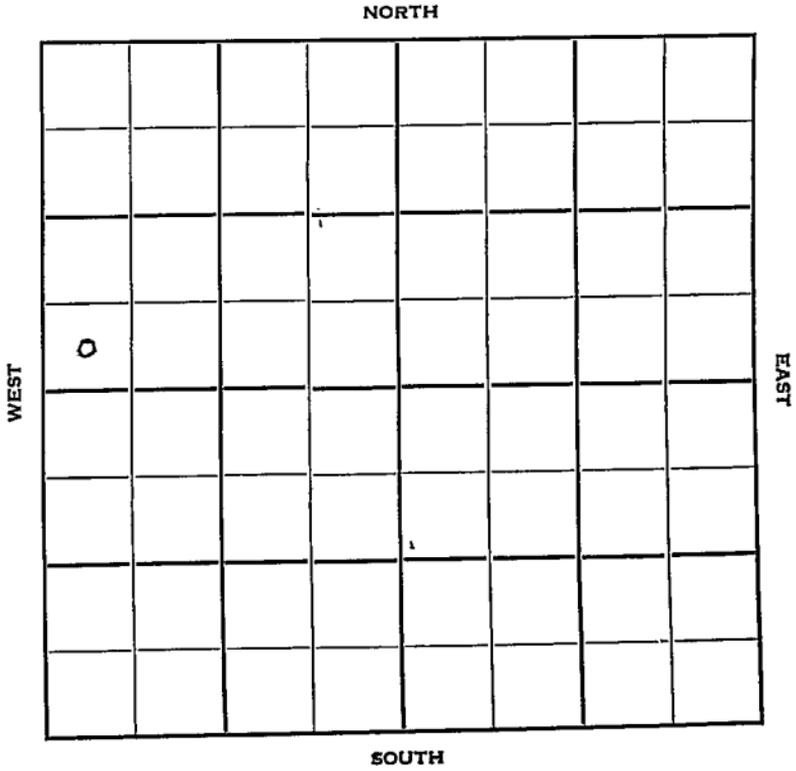

Sec. 8 Twp. 19 R. 11-W

Well No. #1 Birzer Farm

J. C. Dozier Company

Lewis Drlg. Contractor


 Ft. from N. Line

330 Ft. from S. Line

 Ft. from E. Line

330 Ft. from W. Line

SW SW NW

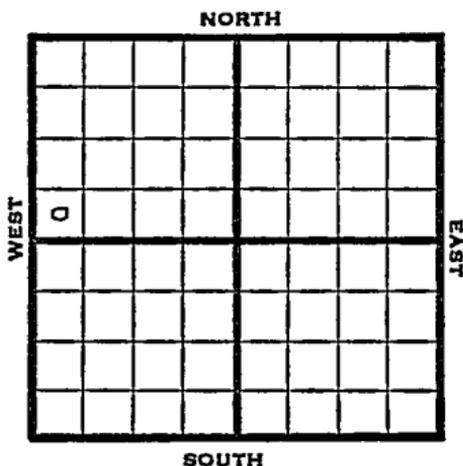

1950

Elev 1774

REPORT

6/7

Location

6/28

T^D 3445

8" @ 172

Anhy 590

Heeb 2962

Br lime 3084

Lans 3105

Arb 3371

√DST 3364-76, opn 40 min rec 11' ocm

DST 3373-85, opn 1 hr rec 35' ocm

trace of oil

5 bwph

D&A

ABANDONED

Map No. _____ Sec. 8 Twp. 19 R. 11W

Well No. 1 Birzer

J. C. Dozier Company

Lewis Drlg. Contractor

S¹ SW NW


_____ Ft. from N. Line

330 Ft. from S. Line

_____ Ft. from E. Line

330 Ft. from W. Line

SECTION PLAT

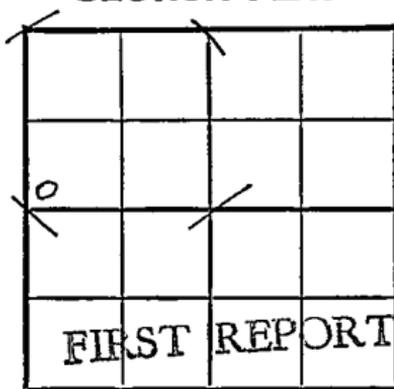

Barton

Location X

Rig up _____

Drilling and Remarks:

RECORD

Cased _____ in., _____ ft.

Sand _____

Gas _____

Oil _____

Total Depth _____

PRODUCTION

1st 24 hrs. Nat. _____

1st 24 hrs. after shot _____

Gas _____ Cu. Ft.

Dry Hole _____

Abandoned _____

Date

JUN 7 1959

J. E. TYRA Scout


1	2
3	4
5	6
99	100

9 17 20 3
 51 2 3 4
 7 2 3 4
 1 2 3 4

JUN 12 1950

Scout Cards	25
Land Small Map	
Land Wall Map	3
Tracings	
France Map	
Pierce Map	
Misc.	

Kansas

Map No. _____ Sec. 8 Twp. 19 R. 11WWell No. 1 BirzerJ. C. Dozier Company

Contractor


SW SW NW

El. 1774
SECTION PLAT

_____ Ft. from N. Line

330 Ft. from S. Line

_____ Ft. from E. Line

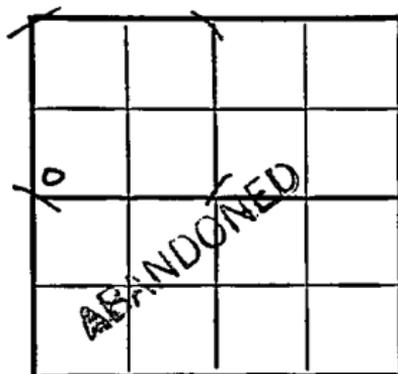330 Ft. from W. Line

Barton County

Location _____

Rig up _____

Drilling and Remarks:

8" @ 172

Anhy 590

Heeb. 2962

Br. lime 3084

Lans. 3105

Arb. 3371

DST 3364-76

open 40 min.

RECORD

Cased _____ in., _____ ft.

Sand _____

Gas _____

Oil _____

Total Depth 3445

PRODUCTION

1st 24 hrs. Nat. _____

1st 24 hrs. after shot _____

Gas _____ Cu. Ft.

Dry Hole _____

Abandoned _____

Rec. 11^r qcm
DateJUN 28 1950 19J. E. TYRA Scout

Scout Cards *76*
 Land Small Map
 Land Wall Map
 Tracings
 France Map
 Pierce Map
 Misc.

JUL 3 1950

D & A
 5 bwpb
 LD 3745

Rec. 354 com
 open 1 hr.

DST 3373-85