

KANAS

Section 8 Township 19 Range 11W

Well No. #2 Birzer

Company Hulme Drlg. Co.

NORTH

[illegible]

SOUTH

WEST

EAST

KANSAS

SEC.	TWP.	R.
8	19	11W

WELL NO.

#2 Birzer FARM

Hulme Drlg. Co.

Co. Tools

Hammeke Pool


330 Ft. from N. Line

_____ Ft. from S. Line

Ft. from E. Line

990 _____ Ft. from W. Line

NE NW NW

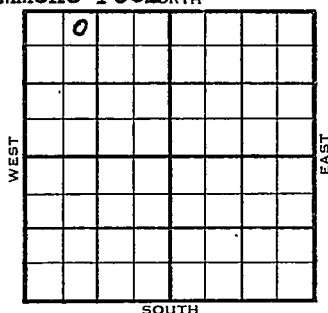

1954	ELEVATION 1803'	REPORT
------	--------------------	--------

9/22 RURT

12/8 Spud 9-19-54

Oil Well

TD 3387

8" @ 2'09"

Heeb 2951', Br. Lime 3069' Lans 3085'

DST 3088'-3136' opn 1 hr, rec 210' o &
gcm, 60' hocm 500#

DST 3147^r-70^r opn 3/4 hr, rec 50^r so &
gcm 175#

DST 3231'-56' opn $\frac{1}{2}$ hr, rec 25' socm

850# Cong 3353' Arb. 3371'

TD 3374'

5" @ 3374'

DD 3387

PB 3150

64/ 3090'-3134' 2 goph 1000 A

S/ 5 boph 8 hr.

P/ 12 boph 6 hr.

Comp 144 bopd.

COMPLETED

County Barton State Kansas
 Sec. 8 (Blk.) 19 (Sur.) 11W Map No. (Twp.)
 Operator Hulme Drlg. Co.
 Well No. 2 Farm Birzer
 Elev. _____ Location NE NW NW

	o						

330 Ft. From N Line NW

990 Ft. From W Line Quarter

Ist. Report SEP 22 1954

Completion _____

Remarks Jim McWilliams -
Co. Tools Geol.


Spudding Date _____

Drlg. Data Hammeke Pool

RIIRT

FABEN GILSTRAP

SEP 21 1958

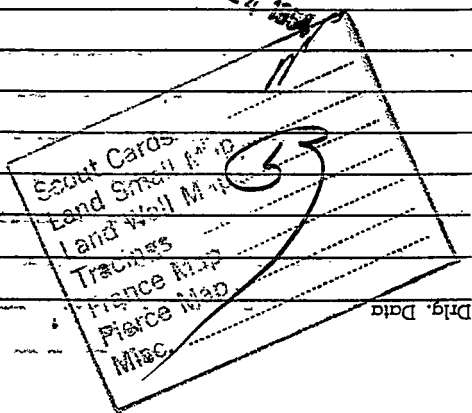

Drig. Data

County Barton State Kansas
 Sec. 8 (Blk. 19 (Sur. 11W Map No.
 (Twp.) (Rge.)

Operator Hulme Drlg.

Well No. 2 Farm Birzer

Elev. 1803 Location NE NW NW

0						

330 Ft. From N Line NW

990 Ft. From W Line Quarter

Ist. Report

Completion DEC 8 1954

Remarks Hammeke Pool

Co. tools

Spudding Date 9-19-54

Drlg. Data Oil well TD 3387

8" @ 209 Heeb. 2951 Br. lime 3069

Lans. 3085 DST 3088-3136 open 1 hr.

Rec. 210' o & gcm 60' hocm 500#

DST 3147-70 open 3/4 hr. Rec. 50' so & gcm 175#

DST 3231-56 open 1/2 hr. Rec. 25' socm 850# Cong. 3353

Arb. 3371 TD 3374 5" @ 3374 DD 3387

PB 3150 64/ 3090-3134 2 goph 1000 A

S/ 5 boph 8 hr. P/ 12 boph 6 hr.

Comp. 144 bopd

FABEN G'LTRAP

DEC 7 5 1954

