


Section 8 Township 19 Range 11-W

Well No. #3 George Robl

Company E H Adair et al

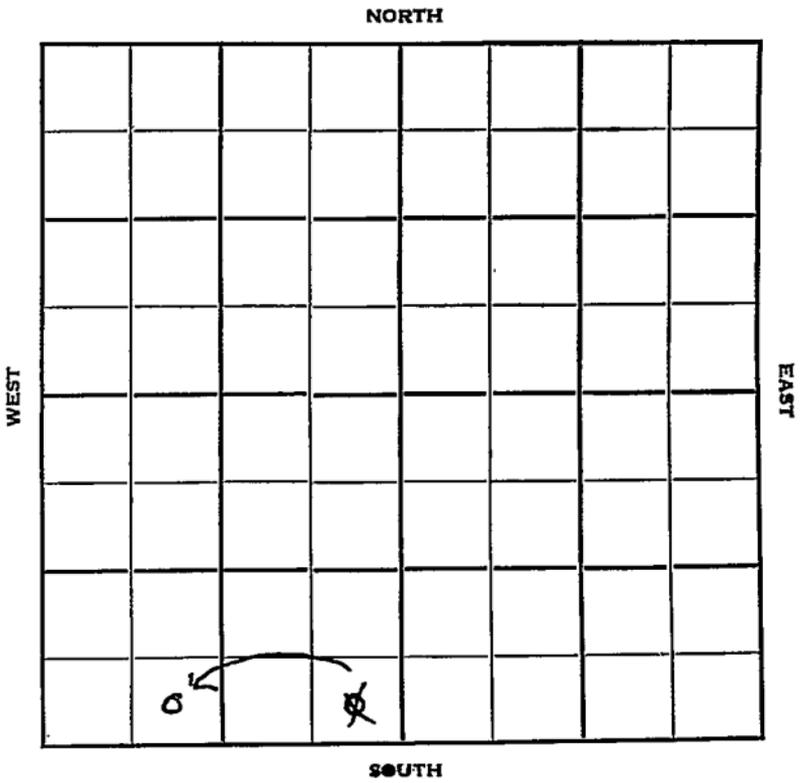

Barton **KANSAS**

Sec. 8 Twp. 19 R. 11W

Well No. #3 George Robl Farm

E. H. Adair et al Company

Gross Drlg. - Contr. Contractor

SE Hammer Pool


 Ft. from N. Line

330' Ft. from S. Line

330' Ft. from E. Line

990' Ft. from W. Line

sw
SE ~~SE~~ SW

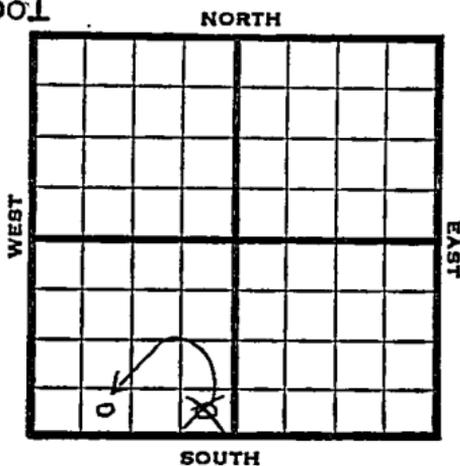

1950

Elev. 1772' REPORT

12/27

Spud 12-18-50
8-5/8" @ 236'
Drlg. 2650'

1951

1/3

Spud 12-18-50
D&A TD 3388
8-5/8" @ 236 Top. 2672
Heeb. 2933 Br Lime 3050
Lans. 3067
DST 3092-3102 opn 1 hr
Rec. 45' so & gcm & wtr
150' sw Cong. 3342 Arb. 3362-88 TD
D&A

ABANDONED

Map No. _____ Sec. 8 Twp. 19 R. 11WWell No. 3 Robl

_____ E. H. Adair et al. _____ Company

CORRECTION

_____ Contractor


SE SW SW

SECTION PLAT

_____ Ft. from N. Line

330 Ft. from S. Line

_____ Ft. from E. Line

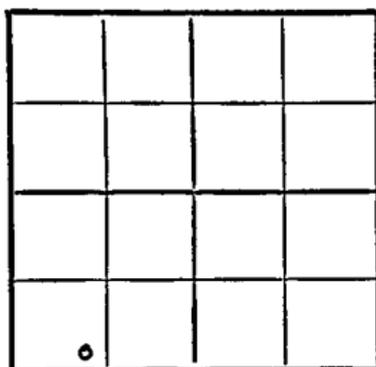990 Ft. from W. Line

Barton County

Location _____

Rig up _____

Drilling and Remarks:

Reported

SE SE SW

RECORD

Cased _____ in., _____ ft.

Sand _____

Gas _____

Oil _____

Total Depth _____

PRODUCTION

1st 24 hrs. Nat. _____

1st 24 hrs. after shot _____

Gas _____ Cu. Ft.


Dry Hole _____

Abandoned _____

Date

DEC 27 1950 19J. E. TYRA Scout

NAME _____
ADDRESS _____
CITY _____

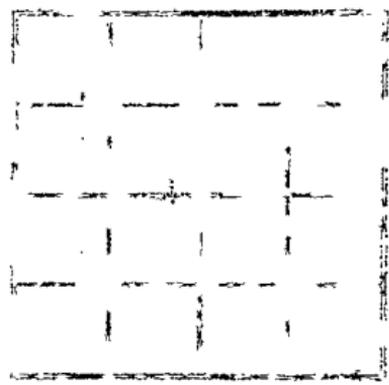

ITEMS _____
DATE _____
BY _____

INDEX

- Scout Cards *JK*
- Land Small Map
- Land Wall Map *3*
- Tracings
- France Map
- Pierce Map
- Misc.


County Barton State Kansas

Sec. 8 (Blk. 19) (Sur. 11W) (Twp.) (Rge.) Map No.

Operator E. H. Adair et al.

Well No. 3 Farm George Robl

Elev. Location - SE SE SW

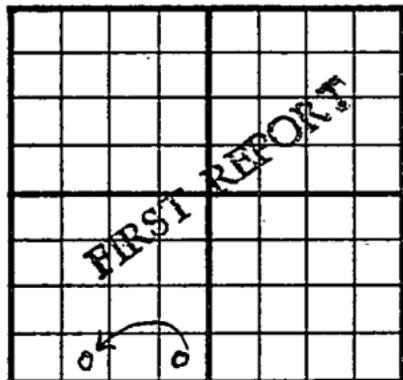

330 Ft. From S Line SW

330 Ft. From E Line Quarter

Ist. Report DEC 27 1950

Completion

Remarks

Gross Drlg. - Contr.

Spudding Date 12-18-50

Drlg. Data SE Hammer Pool

8 5/8" @ 236 drlg. 2650

*see correction
Ticket*

DEC 29 1950

[Handwritten scribbles]

Scout Cards
Land Small Map
Land Wall Map
Tracings
France Map
Picree Map
Misc.

Scout Cards
Land Snail Map
Land Wall Map
Tracings
France Map
Tree Map
Misc.

JAN 8 1959