


Section 8 Township 19 Range 2W **KANSAS**

Well No. #1 Swanson

Company National Assco.

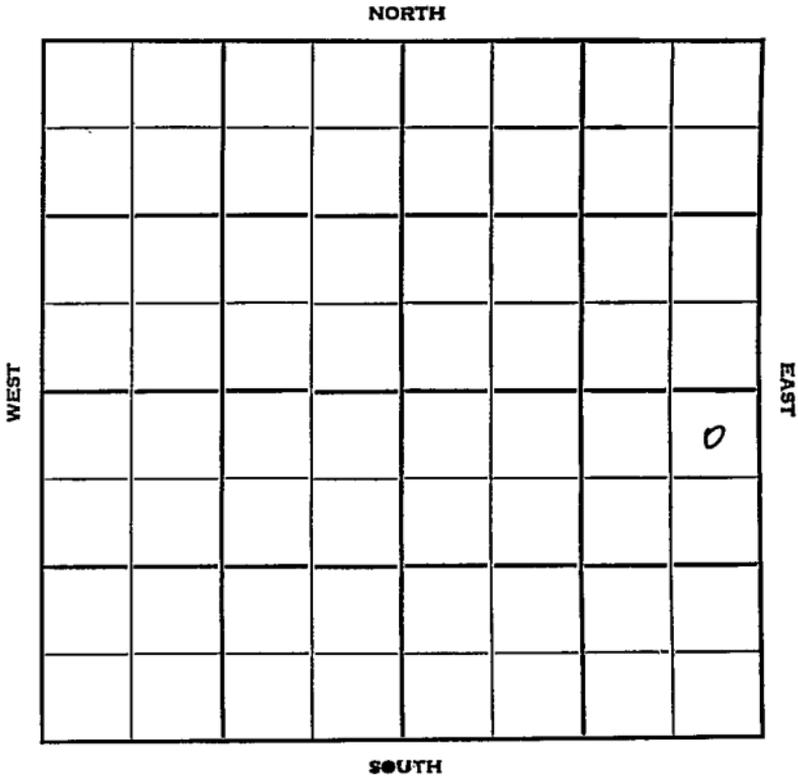

McPherson

KANSAS

Sec. 8 Twp. 19 R. 2W

Well No. #1 Swanson Farm

National Assoc. Company

Edwards - Contr. Contractor

Wildcat


330' Ft. from N. Line

..... Ft. from S. Line

330' Ft. from E. Line

..... Ft. from W. Line

NE NE SE

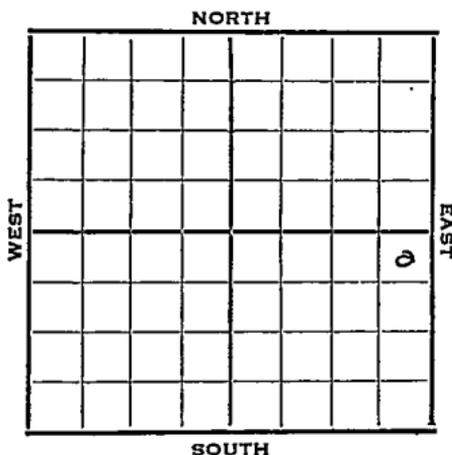

1951 Elev. 1548' REPORT

11/28 Spud 11-18-51
8" @ 128
Drlg 3090'

12/19 Spud 11-18-51
D&A TD 3623
8" @ 128
Lans. 2338
Doug. 2149
Kh. 3182
Viola 3464
Arb. 3570
TD 3623
D&A

Heeb. 2100
Miss. 2922
Maq. 3325
Simp. 3519

ABANDONED

Scout Cards	2
Land Small Map	
Land Wall Map	3
Tracings	
France Map	
Pierce Map	
Misc.	

6 1957


County McPherson State Kansas

Sec. 8 (Blk. 19 (Sur. Rge.) 2W Map No.

Operator National Assoc. Pet.

Well No. 1 Farm Swanson

Elev. 1548 Location : NE NE SE

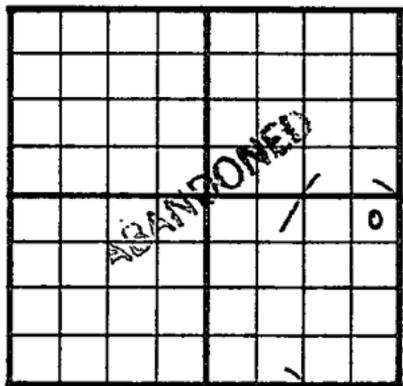

330 Ft. From N Line SE

330 Ft. From E Line Quarter

Ist. Report

Completion DEC 1 9 1951

Remarks Wildcat

Edwards - Contr.

Spudding Date 11-18-51

Drlg. Data D & A TD 3623

8" @ 128 Lans. 2338 Heeb. 2100

Doug. 2149 Miss. 2922 Kh. 3182

Maq. 3325 Viola 3464 Simp. 3519

Arb. 3570 TD 3623

D & A

Scout Cards <i>mr</i>
Land Small Map <i>3</i>
Land Wall Map <i>3</i>
Tracings
France Map
Pierce Map
MISC.

JAN 2 1952

Orig. Data