


Section 8 Township 19 Range 15-W

Well No. #1 Schultz

Company ~~F. H. Hilton~~ Crown Oil ↗

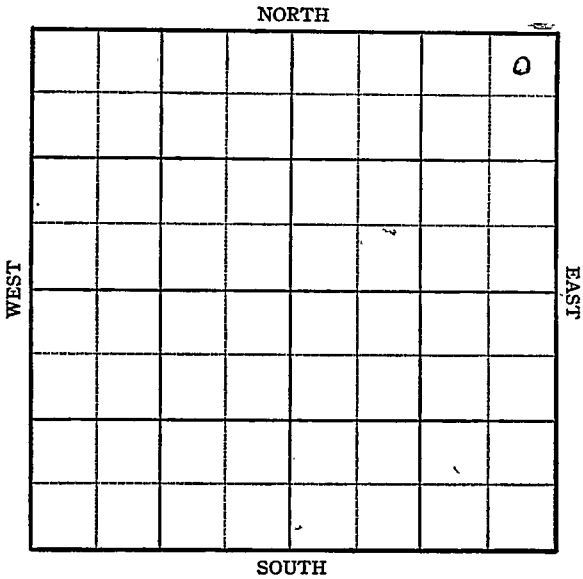

KANSAS

Barton County

Sec. 8 Twp. 19 R. 15W

Well No. #1 Schultz Farm

~~E. M. Hilton~~ C-TOWN Oil Company

Wildcat


330 Ft. from N. Line

_____ Ft. from S. Line

330 Ft. from E. Line

_____ Ft. from W. Line

NE/c

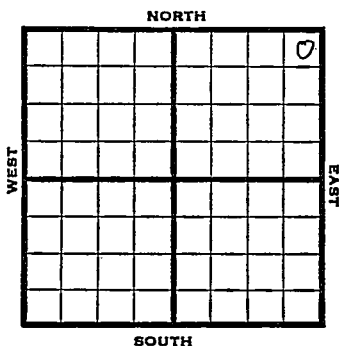

1946 Elev. 1974 REPORT

3/6	RUR
3/14	"
3/21	8" - 973' Anhy 963' Drlg. 1820'
3/28	Drlg. 3070'
4/4	Lans 3281 Cong 3551 Basal 3575 TD 3582 Sat.
4/10	5" @ 3578' RUST TD 3584 Pump 5 oil PH 6 hrs.
4/16	" " "
4/23	Pump 88 oil in 24 hrs.
5/1	" " "
5/7	" " "
5/15	Basal 3575 5" @ 3578 TD 3584' Pump 116 Pot. Grav. 35.7

COMPLETED

KANSAS Kansas

Pool Name Mertens

Map No. 87 Sec. 8- Twp. 19 R. 15W

Well No. 1 Schultz

Crown Oil Company

CORRECTION Contractor

NE/C

SECTION PLAT

330 Ft. from N. Line

_____ Ft. from S. Line

330 Ft. from E. Line

_____ Ft. from W. Line

			o

Barton County

Location _____

Rig up _____

Drilling and Remarks:

Reported

E. M. Hilton

RECORD

Cased _____ in., _____ ft.

Sand _____

Gas _____

Oil _____

Total Depth _____

PRODUCTION

1st 24 hrs. Nat. _____

1st 24 hrs. after shot _____

Gas _____ Cu. Ft.

Dry Hole _____

Abandoned _____

Date

MAY 8 1946

19

S. J. LEWIS Scout

KANSAS Kansas Pool Name Mertens

Map No. 87 Sec. 8 Twp. 19 R. 15W

Well No. 1 Schultz

Crown Oil Company

COMPLETED

Contractor

E. J. 1974

SECTION PLAT

NE/c

			0

330 Ft. from N. Line

_____ Ft. from S. Line

330 Ft. from E. Line

_____ Ft. from W. Line

Barton County

Location _____

Rig up _____

Drilling and Remarks:

Basal 3575
5' @ 8578.
Pump 116 Pd

352 gr.

RECORD

Cased _____ in., _____ ft.

Sand _____

Gas _____

Oil _____

Total Depth 3574

PRODUCTION

1st 24 hrs. Nat. _____

1st 24 hrs. after shot _____

Gas _____ Cu. Ft.

Dry Hole _____

Abandoned _____

Date

MAY 15 1946 19

S. J. LEWIS Scout