


KANSAS Barton

FORM 51 5M 6-46 PETROL

Section 8 Township 19 Range 15-W

Well No. #2 Schultz

Company Crown Oil

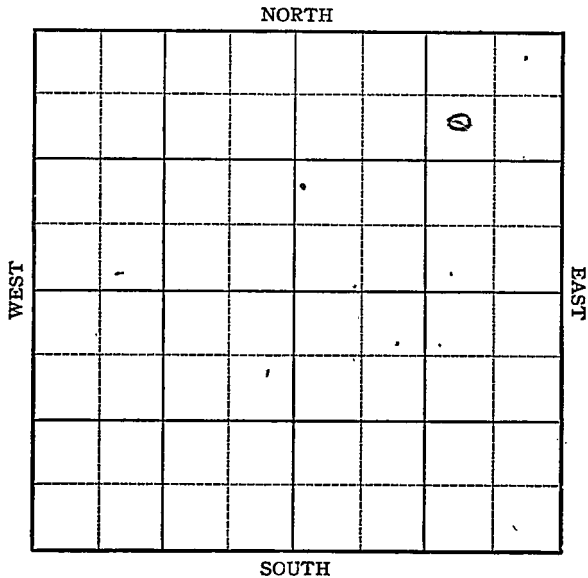

KANSAS

Barton County

Sec. 8 Twp. 19 R. 15W

Well No. #2 Schultz Farm

Crown Oil Company


Mertens

990 Ft. from N. Line

_____ Ft. from S. Line

990 Ft. from E. Line

_____ Ft. from W. Line

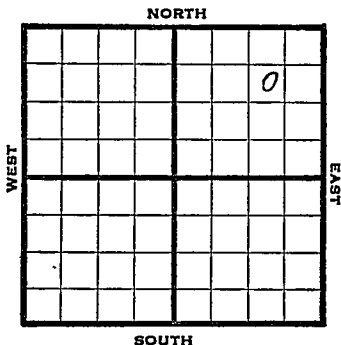

SW NE NE

1946

1986

REPORT

8/14 470'

8/20 Anhy 975
8" @ 993

Drlg 2510'

8/27 Lans 3300

BKC 3537

Cong 3572

Reagan 3593

TD 3599-5" @ 3 594 RUST

9/5 TD 3607

Flow 22 oil PH

9/10 " "

9/18 " "

9/25 Reagan 3593'

5" @ 3594'

TD 3607'

Bomb & Pot

Grav 37

COMPLETED

KANSAS

Kansas Pool Name Mertens

Map No. 82 Sec. 8 Twp. 19 R. 15W

Well No. 2 Schult_z

Crown Oil Company

FIRST REPORT

Contractor

SW NE NE

SECTION PLAT

			o

990 Ft. from N. Line

_____ Ft. from S. Line

990 Ft. from E. Line

_____ Ft. from W. Line

Barton County

RECORD

Location _____

Cased _____ in., _____ ft.

Rig up _____

Sand _____

Drilling and Remarks:

Gas _____

Oil _____

470'

Total Depth _____

PRODUCTION

1st 24 hrs. Nat. _____

1st 24 hrs. after shot _____

Gas _____ Cu. Ft.

Dry Hole _____

Abandoned _____

Date

AUG 14 1945 19

S. J. LEWIS

Score

KANSAS KansaPool Name Mertens Pool

Map No. 82 Sec. 8 Twp. 19 R. 15W

Well No. 2 Schultz

Crown Oil Company

COMPLETED

Contractor

SW NE NE

E 11986
SECTION PLAT

			6

990 Ft. from N. Line

_____ Ft. from S. Line

990 Ft. from E. Line

_____ Ft. from W. Line

Barton County

Location _____

Rig up _____

Drilling and Remarks:

Reagan 5593

5123094

Bone 27 263

27 263

RECORD

Cased _____ in., _____ ft.

Sand _____

Gas _____

Oil _____

Total Depth 3607

PRODUCTION

1st 24 hrs. Nat. _____

1st 24 hrs. after shot _____

Gas _____ Cu. Ft.

Dry Hole _____

Abandoned _____

Date

SEP 25 1946 19

S. J. LEWIS

Scout