


KANSAS Barton

FORM 51 5M 6-46 PETROL

Section 8 Township 19 Range 15-W

Well No. #2 Schultz

Company Amerada

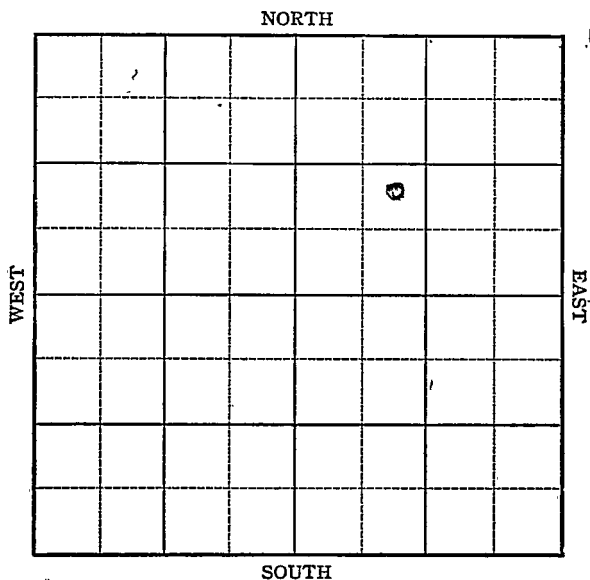


Sec. 8 Twp. 19 R. 15WWell No. #2 Schultz FarmAmerada Company

Mertens

 Ft. from N. Line990 Ft. from S. Line Ft. from E. Line990 Ft. from W. Line

NE SW NE

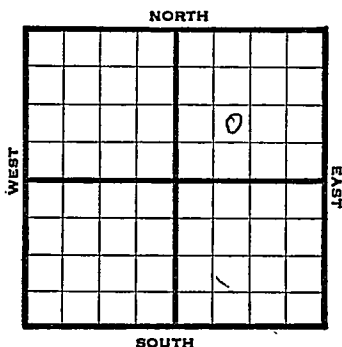

1946 Elev 1998' REPORT

8/14 Surface hole.

8/20 Anhy 986
8" @ 993 WOC8/27 Lans 3299
Cong 3578'
Reagan 3606'
TD 3613 run csg

9/5 5" @ 3608 RUST

9/10 3606 Gorham corrected
Arb 3613
Reagan 3619
TD 3623
Flow 329 oil in 6½ hrs.

9/18 " " "

9/25 Reagan 2619'
5" @ 3613'
TD 3623'
Bomb & Pot 2098'
Grav 37

COMPLETED

Kansas Pool Name Mertens

KANSAS 2
 Map No. 8 Sec. 8 Twp. 19 R. 15W

Well No. 2 SchultzAmerada

Company

FIRST REPORT

Contractor

NE SW NE

SECTION PLAT

		0	
		1	

Ft. from N. Line990 Ft. from S. LineFt. from E. Line990 Ft. from W. LineBarton County

Location _____

Rig up _____

Drilling and Remarks:

Surface Hole

RECORD

Cased _____ in., _____ ft.

Sand _____

Gas _____

Oil _____

Total Depth _____

PRODUCTION

1st 24 hrs. Nat. _____

1st 24 hrs. after shot _____

Gas _____ Cu. Ft.

Dry Hole _____

Abandoned _____

Date

AUG 14 194619S. J. LEWIS

Scout

KANSAS

Kansas Pool Name Mertens PoolMap No. 82 Sec. 8 Twp. 19 R. 15WWell No. 2 SchultzAmerada

Company

COMPLETED

Contractor

NE SW NE

E 11998
SECTION PLAT

		0	

 Ft. from N. Line990 Ft. from S. Line Ft. from E. Line990 Ft. from W. LineBarton CountyLocation Rig up

Drilling and Remarks:

Reagan 36193619Born & 2098070 82**RECORD**Cased in, ft.Sand Gas Oil Total Depth 3623**PRODUCTION**1st 24 hrs. Nat. 1st 24 hrs. after shot Gas Cu. Ft.Dry Hole Abandoned

Date

SEP 25 1946 19S. J. LEWIS Scout