
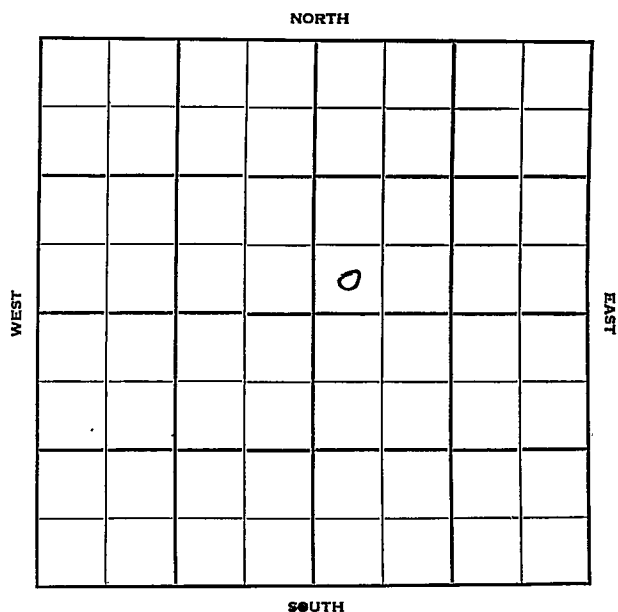


Section 8 Township 19 Range 13WWell No. #1 CookCompany Sohio

Sec. 8 Twp. 19 R. 13WWell No. #1 Cook FarmSohio CompanyHarms & Knight - Contr. ContractorWildcat1 Ft. from N. Line330' Ft. from S. Line Ft. from E. Line330' Ft. from W. Line

SW SW NE

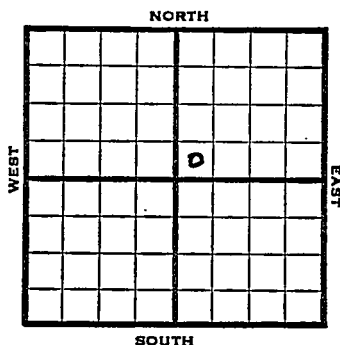

1952

Elev. 1858' REPORT

7/2	Location
7/9	"
7/17	"
7/23	"
7/30	"
8/6	"
8/13	"
8/20	"
8/27	"
9/3	"
9/10	MI
9/17	8" @ 427' Drlg. 2350'
9/24	Heeb. 3095 Dodge 3110 Br Li 3188 Lans. 3201 DST 3207-24 1 hr. 18' M DST 3237-55 1 hr. 30' M DST 3258-95 1 hr. 30' M & SSO Drlg. 3300'
10/1	DST 3323-35, 1 hr, 114' SGCM 1240# DST 3338-85', 1 hr, 980' GCO, 300' muddy GCO 900# DST 3392-3415, 1 hr, 180' gas, 120' O&GCM, 30' HO & GCM, 60' fluid. 50% oil, 55' GCO. Arb. 3443' RTD 3449' 5" @ 3448'

OVER

1952

10/8 Sch tops: Br Li 3192 Lans. 3205
Cong. 3421 CO to 3450 1/2 boph
50A 11 gw 500 A S/ 60 gas tr.
wtr. 6 hr. 1500 A S/ 2 1/4 BO
3/4 bwph

10/15 DD 3469 TD
S/4 BWPH SP 3440, 28/3347-54
1000A 13 BOPH
POP

10/22 NR

10/29 P/100 BOPD

11/5 Spud. 9-11-52

Oil Well TD 3469'

8" @ 427'

Heeb. 3095

Dodge 3100

Br Li 3192

Lans. 3205

DST 3207-24 open 1 hr. rec. 10' mud O#

DST 3237-55 open 1 hr. rec. 30' mud O#

DST 3258-95 open 1 hr. rec. 30' mud SS

DST 3323-35 open 1 hr. rec. 114' sgcm
1240#

DST 3338-85 open 1 hr. rec. 980' gco
300' muddy gco 900#

DST 3392-3415 open 1 hr. rec. 180' gas

120' o&gcm 30' ho & gcm 60' fluid

55' gco 920# Arb. 3443

TD 3449 5" @ 3448 CO to 3450

Cong. 3421 1/2 boph 50 A

11 gw 500 A S/ 60 go 6 hr.


1500 A S/ 2 1/2 bo 3/4 bwph

DD 3469 S/ 4 bwph SP 3440

28/ 3447-54, 1000 A 13 boph 10 hr.

Comp. 190 bopd

COMPLETED

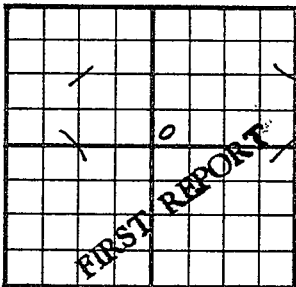County Barton State KansasSec. 8 (Blk. Twp.) 19 (Sur. Rge.) 13W Map No.Operator SchieWell No. 1 Farm CookElev. Location SW SW NE330 Ft. From S Line NE330 Ft. From W Line Quarter1st. Report JUL 2 1952

Completion

Remarks


Harms & Knight - Contr.

Spudding Date

Drlg. Data WildcatLocation

J. G. McGEHEE

County Barton State Kansas
 Sec. 8 (Blk.) 19 (Sur.) 13W Map No. _____
 Operator Sohio Oil
 Well No. 1 Farm Cook
 Elev. 1858 Location SW SW NE

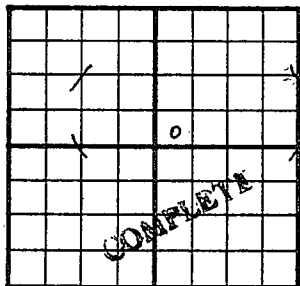

330 Ft. From S Line NE
330 Ft. From W Line Quarter
 Ist. Report _____
 Completion NOV 5 1952
 Remarks Wildcat
Harms & Knight - Contr.
 Spudding Date 9-11-52

Drlg. Data Oil well TD 3469
8" @ 427 Heeb. 3095 Dodge 3110
Br. line 3192 Lans. 3205 DST 3207-24
open 1 hr. Rec. 10' mud 0# DST 3237-55
open 1 hr. Rec. 30' mud 0# DST 3258-95
open 1 hr. Rec. 30' mud SSO DST 3323-35
open 1 hr. Rec. 114' sgcm 1240#
DST 3338-85 open 1 hr. Rec. 980' gco
300' muddy gco 900# DST 3392-3415
open 1 hr. Rec. 180' gas 120' o & gcm
30' ho & gcm 60' fluid 55' gco 920#
Arb. 3443 TD 3449 5" @ 3448 CO to 3450
Cong. 3421 $\frac{1}{2}$ boph 50A 11 gw 500 A
S/ 60 go 6 hr. 1500 A S/ $2\frac{1}{4}$ bo $3\frac{3}{4}$
bwph DD 3469 S/ 4 bwph SP 3440

J. G. McGEHEE

Drlg. Data

28/ 3347-54 1000 A 13 bosh 10 hr.

Comp. 190 bosh

NOV 12 1952

.....	Misc.
.....	Pierce Map
.....	France Map
.....	Tracings
.....	Land Wall Map
.....	Land Small Map
.....	Scout Cards

W