
KANSAS Barton County

FORM 51 5M PETROL

Section 8 Township 19 Range 15W

Well No. 1 Arnold

Company Inland Oil

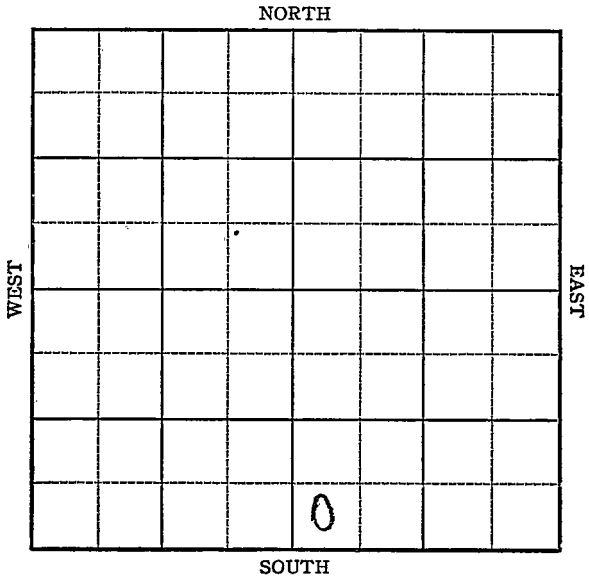

FORM 252-A
5M 3-45 PETROL

KANSAS

Barton

Sec. 8 Twp. 19 R. 15W

Well No. 1 Arnold Farm

Inland Oil Company

Mertens


____ Ft. from N. Line

330 Ft. from S. Line

____ Ft. from E. Line

330 Ft. from W. Line

SW SE Elev. 2003

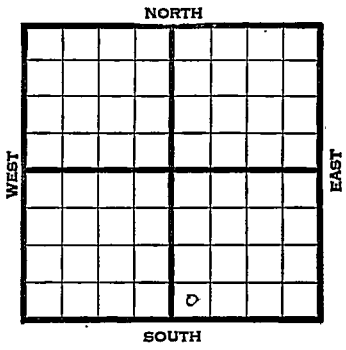

1945	REPORT
5/16	970
5/24	Anh 992 8" @ 1003 Drlg. 2418'
6/6	Lans 3328 Cong 3578 Arb. 3669 TD 3683

ABANDONED

FORM 26 200 BKS. 2-44 PETROL

Kansas Pool Name Mertens

Map No. 82 Sec. 8 Twp. 19 R. 15W


Well No. 1 Arnold

Inland Oil Company

FIRST REPORT Contractor

SW SE

SECTION PLAT

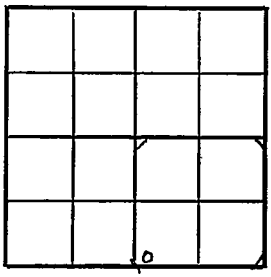

____ Ft. from N. Line

330 Ft. from S. Line

____ Ft. from E. Line

330 Ft. from W. Line

Barton

Location

Rig up

Drilling and Remarks:

970

RECORD

Cased ____ in., ____ ft.

Sand

Gas

Oil

Total Depth

PRODUCTION

1st 24 hrs. Nat.

1st 24 hrs. after shot

Gas ____ Cu. Ft.

Dry Hole

Abandoned

Date

MAY 16 1945

19 ____ S. J. LEWIS Scout

FORM 26 200 BKS. 2-44 PETROL

Kansas Pool Name Mertens

Map No. 82 Sec. 8 Twp. 19 R. 15W

Well No. 1 Arnold


Inland Oil Company

ABANDONED Contractor

SW SE

E1.2003

SECTION PLAT

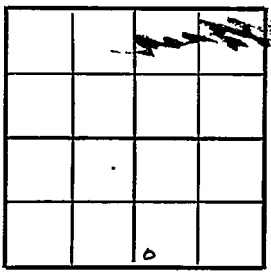

____ Ft. from N. Line

330 Ft. from S. Line

____ Ft. from E. Line

330 Ft. from W. Line

Barton County

Location

Rig up

Drilling and Remarks:

Lime 3328
Conq. 3578
RTD 3669

RECORD

Cased ____ in., ____ ft.

Sand

Gas

Oil

Total Depth 3683

PRODUCTION

1st 24 hrs. Nat.

1st 24 hrs. after shot

Gas ____ Cu. Ft.

Dry Hole

Abandoned

Date

JUN 6 1945 19 S. J. LEWIS Scout