


Section 9 Township 19 Range 12 W

Well No. # 1 Hammeke

Company Aladdin & Crow

NORTH

2

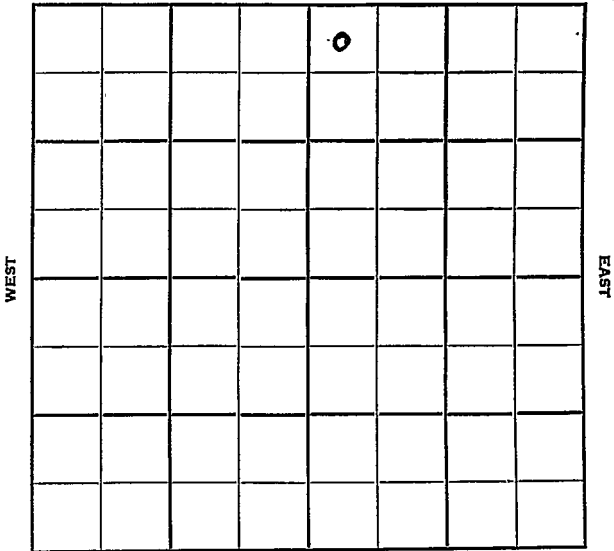

SOUTH

Sec. 9 Twp. 19 R. 12 W ✓

Well No. # 1 Hammeke Farm

Alladdin & Crow Company

Crow Contractor

Wildcat


330 Ft. from N. Line

..... Ft. from S. Line

..... Ft. from E. Line

330 Ft. from W. Line

NW NW NE

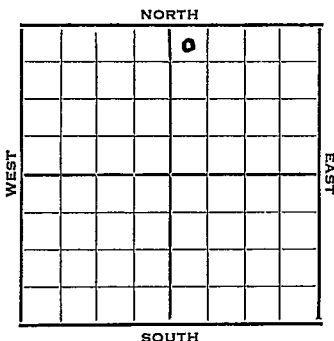

1952

Elev. 1826'

REPORT

4/9

Spud 4-4-52

8" @ 200

Anhy 660'

Drlg. 2475'

4/16

Spud 4-4-52

D&A TD 3435' 8" @ 200

Anhy 660

Heeb. 3013

Br Li 3125

Lans. 3141

DST 3137-81 open 1/2 hr. rec. 10' mud

Cong. 3392

Cherty Cong. 3400

Arb. 3413

TD 3435' D&A

*** ABANDONED**

County Barton State Kansas

Sec. 9 (Blk. 19 Twp.) (Sur. 12W Rge.) Map No.

Operator Aladdin & Crowe

Well No. 1 Farm Hammeke

Elev. 1826 Location NW NW NE

			0		

330 Ft. From N Line NE

330 Ft. From W Line Quarter

1st. Report

Completion APR 16 1952

Remarks Wildcat

Crowe Drlg. - Contr.

Spudding Date 4-4-52

Drlg. Data D & A TD 3435

8" @ 200 Anhy 660 Heeb. 3013

Br. lime 3125 Lans. 3141 DST 3137-81

open $\frac{1}{2}$ hr. Rec. 10' mud Cong. 3392

Cherty Cong. 3400 Arb. 3413 TD 3435

D & A

J. G. McGEHEE