


Section 9 Township 19 Range 12-W

Well No. #1 Wess

Company Ben Brack Oil

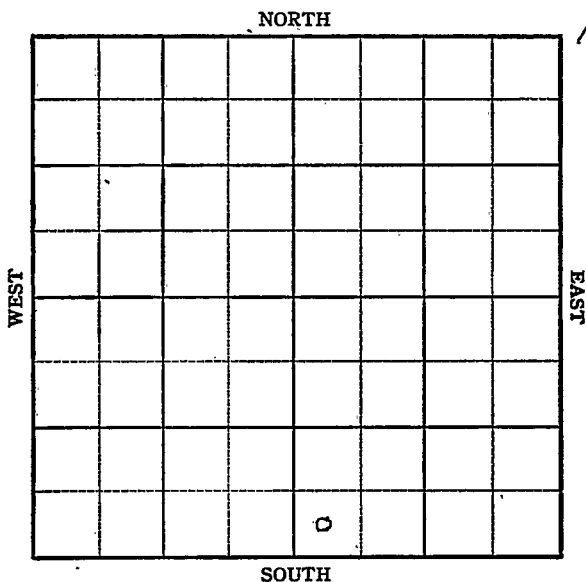

KANSAS

Barton

Sec. 9 Twp. 19 R. 12-W

Well No. #1 Wess Farm

Ben Brack Oil Company

Contractor

Wildcat


 Ft. from N. Line

330 Ft. from S. Line

 Ft. from E. Line

330 Ft. from W. Line

SW SW SE

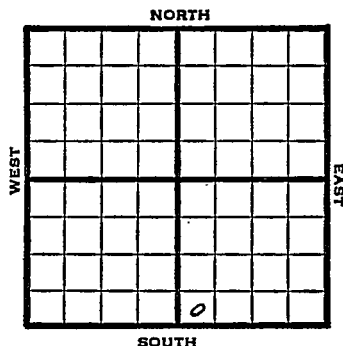

1950

Elev 1849

REPORT

5/17 Location

6/21 TD 3438

8" @ 212

Lans 3151

DST 3233-41 opn $\frac{1}{2}$ hr rec 8' mud

Cong 3406

Arb 3434-38

D&A

ABANDONED

Map No. _____ Sec. 9 Twp. 19 R. 12W

Well No. 1 Wess

~~Bon Brack Oil~~ _____ Company

_____ Contractor

SW ST SE

_____ Ft. from N. Line

330 Ft. from S. Line

_____ Ft. from E. Line

330 Ft. from W. Line

SECTION PLAT



Barton

Location X

Rig up _____

Drilling and Remarks:

RECORD

Cased _____ in., _____ ft.

Sand _____

Gas _____

Oil _____

Total Depth _____

PRODUCTION

1st 24 hrs. Nat. _____

1st 24 hrs. after shot _____

Gas _____ Cu. Ft.

Dry Hole _____

Abandoned _____

Date

MAY 17 1950

_____ 19

J. E. TYRA

Scout

Map No. _____ Sec. 9 Twp. 19 R. 12WWell No. 1 WessBen Brack Oil Company

Contractor


SW SW SE

E1. 1849
SECTION PLAT

_____ Ft. from N. Line

330 Ft. from S. Line

_____ Ft. from E. Line

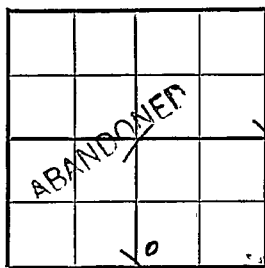330 Ft. from W. LineBarton County

Location _____

Rig up _____

Drilling and Remarks:

8" C 212

Lans. 3151

DST 3233-41

open 1/2 h₂o.

Rec. 8' mud

Cong. 3406

Arb. 3434 38

RECORD

Cased _____ in., _____ ft.

Sand _____

Gas _____

Oil _____

Total Depth 3438

PRODUCTION

1st 24 hrs. Nat. _____

1st 24 hrs. after shot _____

Gas _____ Cu. Ft.

Dry Hole _____

Abandoned _____

Date D & AJUN 21 1950 19 J. E. TYRA Scout