


Section 9 Township 19 Range 11W

Well No. 1 Musenberg "H"

Company G. E. Ash

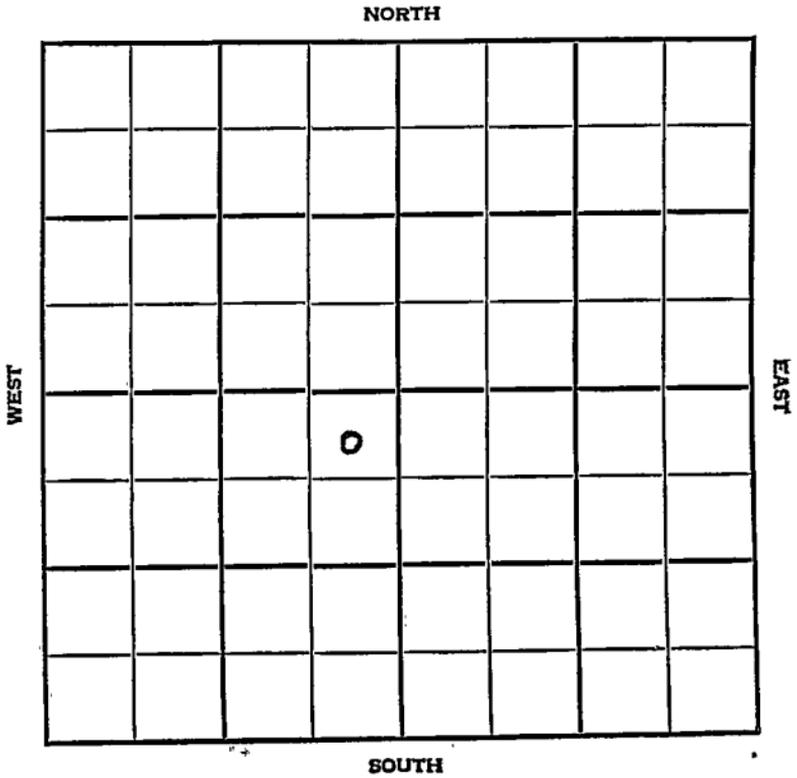

ANNONS

Barton


SEC.	TWP.	R.
9	19	11W

WELL NO. #1 Musenberg "H" FARM

COMPANY C.E. Ash

CONTRACTOR Bea

Wildcat.
 330 Ft. from N. Line
 _____ Ft. from S. Line
 330 Ft. from E. Line
 _____ Ft. from W. Line

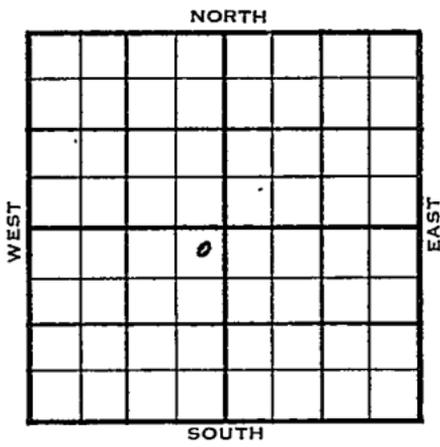

NE NE SW

	ELEVATION	REPORT
1955	1765'	
2/23	Spud 2-18-55 8" @ 225' Anhy 570' Drlg. 1396'	
3/2	Spud 2-18-55 - D&A TD 3426' 8" @ 225' Anhy 570', Top. 2673', Heeb. 2937', Br line 3053', 7 ans. 3072', Cong 3372', Arb. 3406' TD 3426' D&A	

ABANDONED


County Barton State Kansas

Sec. 9 (Blk. Twp.) 19 (Sur. Rge.) 11W Map No.

Operator C. E. Ash

Well No. 1 Farm Musenberg "H"

Elev. _____ Location NE NE SW

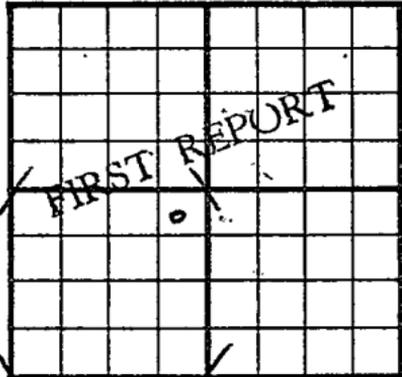

330 Ft. From N Line SW

330 Ft. From E Line Quarter

1st. Report FEB 23 1955

Completion _____

Remarks _____

Bea - Contr.

Spudding Date 2-18-55

Drlg. Data Wildcat

8" @ 225 Anhy 570 drlg. 1396

FABEN GILSTRAP


County Barton State Kansas

Sec. 9 (Blk. 19 (Sur. Rge.) 11W Map No.

Operator C. E. Ash

Well No. 1 Farm Musenberg "H"

Elev. 1765 Location NE NE SW

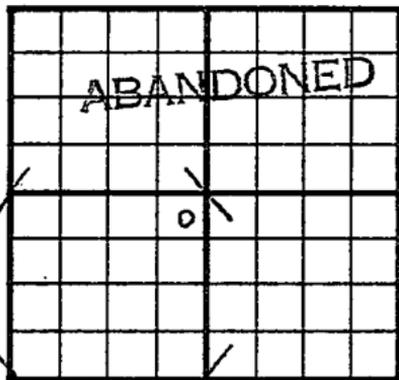

330 Ft. From N Line SW

330 Ft. From E Line Quarter

1st. Report

MAR 2 1955

Completion

Remarks Wildcat

Bea - Contr.

Spudding Date 2-18-55

Drig. Data D & A TD 3426

8" @ 225 Anhy 570 Top. 2673

Heeb. 2937 Br. lime 3053 Lans. 3072

Cong. 3372 Arb. 3406 TD 3426

D & A

FABEN GILSTRAP