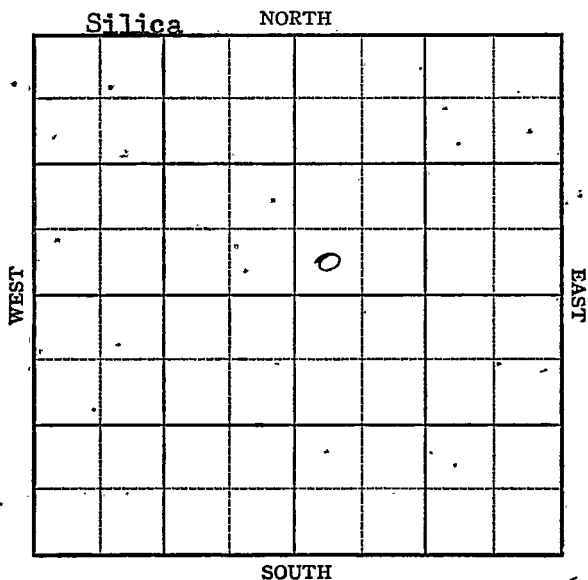


KANSAS

Rice

Section 9 Township 19 Range 10WWell No. 1 GillCompany Westgate-Greenland

KANSAS

Rice

Sec. 9 Twp. 19 R. 10-W

Well No. #1 Gill Farm
Westgate-Greenland Company


 Ft. from N. Line

330 Ft. from S. Line

 Ft. from E. Line

330 Ft. from W. Line

SW SW NE

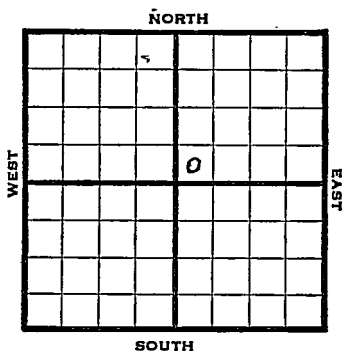

1947 Elev. 1759' REPORT

4/9 Location

4/15 "

4/23 10" @ 192'
Drlg 825'

4/29 Drlg 2650'

5/7 Lens 3002
Arb 3351
TD 3390'

ABANDONED


Map No. K46 Sec. 9 Twp. 19 R. 10WWell No. 1 GillWestgate-Greenland

Company

FIRST REPORT

Contractor

SW SWNE

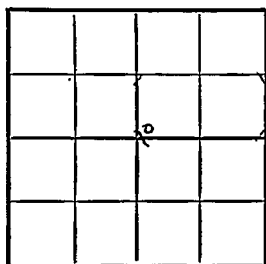SECTION PLAT Ft. from N. Line330 Ft. from S. Line Ft. from E. Line330 Ft. from W. LineRice CountyLocation XRig up

Drilling and Remarks:

RECORDCased in., ft.Sand Gas Oil Total Depth **PRODUCTION**1st 24 hrs. Nat. 1st 24 hrs. after shot Gas Cu. Ft.Dry Hole Abandoned

Date

APR 9 1947 19S. J. LEWIS

Scout

Kansas

KANSAS

Silica Pool

Map No. R46 Sec. 9 Twp. 19 R. 10WWell No. 1 GillWestgate-Greenland

Company


ABANDONED

Contractor

SW NE

E11709

SECTION PLAT

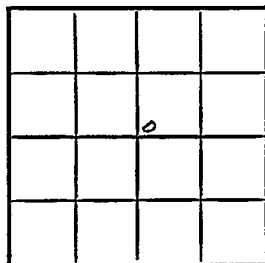 Ft. from N. Line330 Ft. from S. Line Ft. from E. Line330 Ft. from W. LineRice CountyLocation Rig up

Drilling and Remarks:

Lane 3002Cur 3307**RECORD**Cased in., ft.Sand Gas Oil Total Depth 3300**PRODUCTION**1st 24 hrs. Nat. 1st 24 hrs. after shot Gas Cu. Ft.Dry Hole Abandoned

Date

MAY 7 1947 19S. J. LEWIS Scout