Rice


FORM 51

KANSAS

Section 9 Township 19 Range 10W

Well No. 1 Matthaei

Company Lewis Drlg.

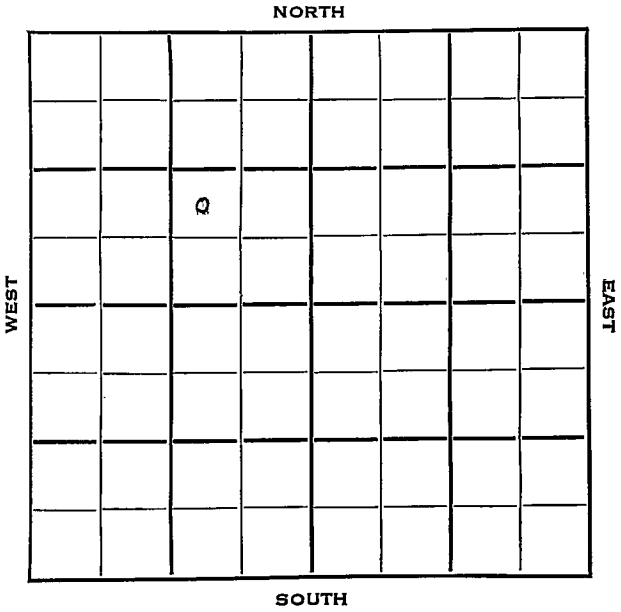

FORM 252-B
10M 8-51 TPCO.

Rice KANSAS ✓

Sec. 9 Twp. 19 R. 10 W

Well No. # 1 Matthaei Farm

Lewis Drlg. Company

Contractor

IXL Pool


Ft. from N. Line

990 Ft. from S. Line

990 Ft. from E. Line

Ft. from W. Line

NW SE NW

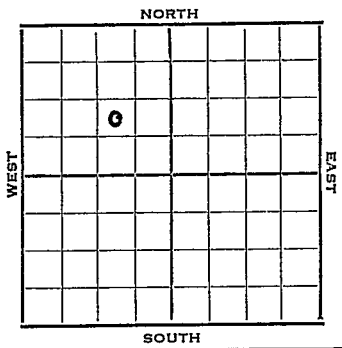

Elev. 1762'

1953	REPORT
4/8	RUR
4/16	8" @ 203 Anhy 495 Drlg. 3060'
4/22	Spud 4-7-53 D&A TD 3356 8" @ 203 Anhy 495, Heeb 2857, Br Lime 2978, Lans 2998 DST 3064-80, opn 1 hrs., rec. 50' O&GCM, 5' mud & wtr.,120# Cong 3306 TD 3356 D&A

ABANDONED

FORM 275 FOR SALE BY KANSAS BLUE PRINT CO.


County Rice State Kansas

Sec. 9 (Blk. Twp.) 19 (Sur. Rge.) 10W Map No.

Operator Lewis Drlg.

Well No. 1 Farm Matthaei

Elev. Location NW SE NW

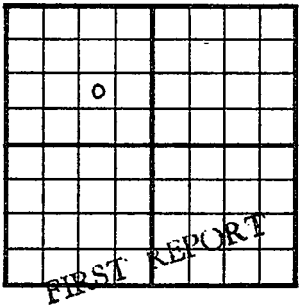

990 Ft. From S Line NW

990 Ft. From E Line Quarter

1st. Report APR 8 1953

Completion

Remarks

Spudding Date

Drlg. Data IXL Pool

R U R

J. G. McGEHEE

FORM 275 FOR SALE BY KANSAS BLUE PRINT CO.


County Rice State Kansas

Sec. 9 (Blk. Twp.) 19 (Sur. Rge.) 10W Map No.

Operator Lewis Drlg.

Well No. 1 Farm Matthaei

Elev. 1762 Location NW SE NW

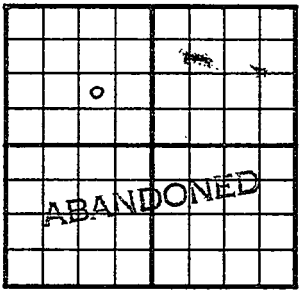

990 Ft. From S Line NW

990 Ft. From E Line Quarter

1st. Report

Completion APR 2 2 1953

Remarks IXL Pool

Spudding Date 4-7-53

Drlg. Data D & A TD 3356

8" @ 203 Anhy 495 Heeb. 2857

Br. lime 2978 Lans. 2998 DST 3064-80

open 1 hr. Rec. 50' o & gcm 5' mud&

wtr. 120# Cong. 3306 TD 3356

D & A

J. G. McGEHEE