


Section 9 Township 19 Range 10WWell No. #2 GillCompany Skiles

NORTH

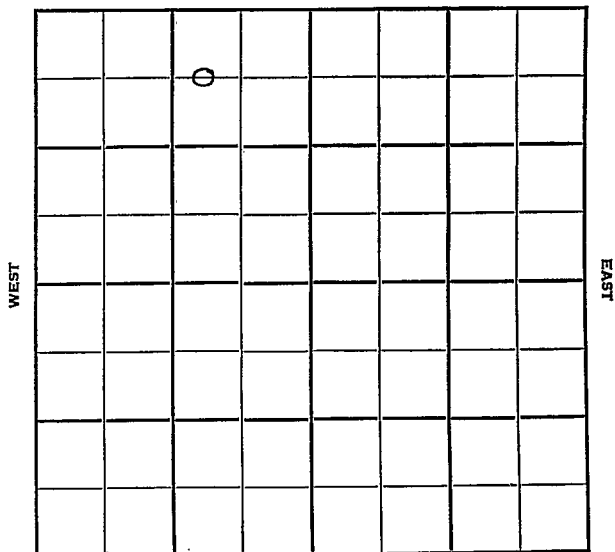

SOUTH

Rice

KANSAS

Sec. 9 Twp. 19 R. 10W

Well No. #2 Gill Farm

Skiles

Company

Skiles

Contractor

660

Ft. from N. Line


Ft. from S. Line

990

Ft. from E. Line

Ft. from W. Line

C W/2 NE NW

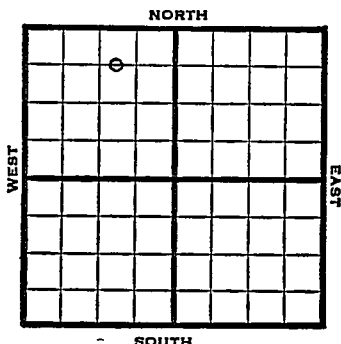


1952

Elev. 1760'

REPORT

3/5 Location
3/11 Drlg. 1500'
3/19 8" @ 190'
Cong. 3303' Drlg. 3310'
3/25 Lans. 3002' Arb. 3252
Sch. 5" @ 3352 TD 3352-3319
4/1 36/3328-40 500 A Fill up
3052 oil, POP
4/9 "
4/23 NR
4/30 Spud 3-5-52
Oil well TD 3352' 8" @ 190
Cong. 3303' Lans. 3002' Arb. 3319'
TD 3352' 5" @ 3352 36/3328-40
500 A FU to within 300' of top of
hole w/oil
Comp. 441 BOPD 2% water.

COMPLETED

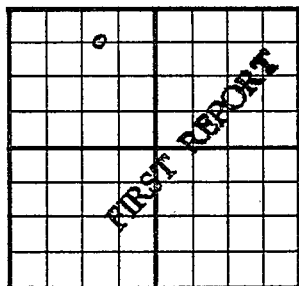County **Rice** State **Kansas**Sec. **9** (Blk.) **19** (Sur.) **10W** Map No. (Twp.)Operator **Skiles**Well No. **2** Farm **Gill**Elev. Location **C W/2 NE NW**660 Ft. From **N** Line **NW**990 Ft. From **E** Line Quarter1st. Report **MAR 5 1952**

Completion

Remarks


Skiles - Contr.

Spudding Date

Drlg. Data

Location**J. G. McGEHEE**

County Rice State Kansas
 Sec. 9 (Blk.) 19 (Sur.) 10W Map No.
 Operator Skiles Oil
 Well No. 2 Farm Gill
 Elev. 1760 Location C W L NE NW

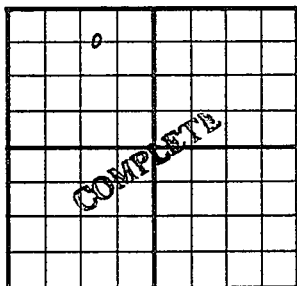

660 Ft. From N Line NW
990 Ft. From E Line Quarter
 1st. Report

Completion APR 30 1952

Remarks

Skiles - Contr.

Spudding Date 3-5-52

Drlg. Data Oil well TD 3352

8" @ 190 Cong. 3303 Lans. 3002

Arb. 3319 TD 3352 5" @ 3352

36/ 3328-40 500 A FU to within 300'

of top of hole w/ oil

Comp. 441 bopd 2% water