


DX 78-1

McPherson KANSAS

Section 9 Township 19 Range 2 W

Well No. # 1 Nelson

Company E. K. Carey

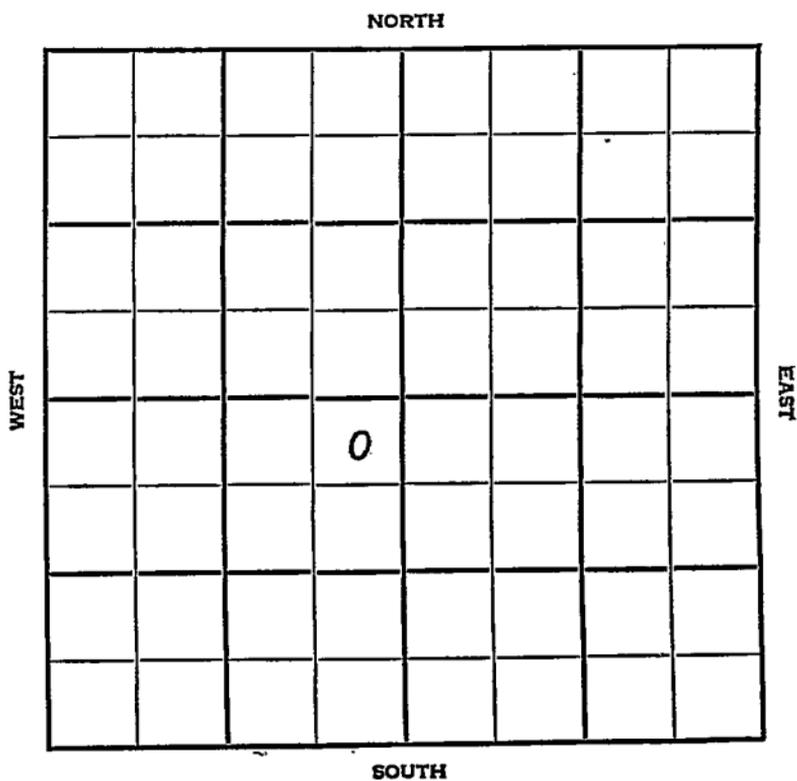

McPherson KANSAS

SEC.	TWP.	R.
9	19	2W
WELL NO.		
I Nelson		FARM
COMPANY		
E. K. Carey		
CONTRACTOR		

Co. Tools
Ritz-Canton Pool


330 _____ Ft. from N. Line

_____ Ft. from S. Line

330 _____ Ft. from E. Line

_____ Ft. from W. Line

NE NE SW

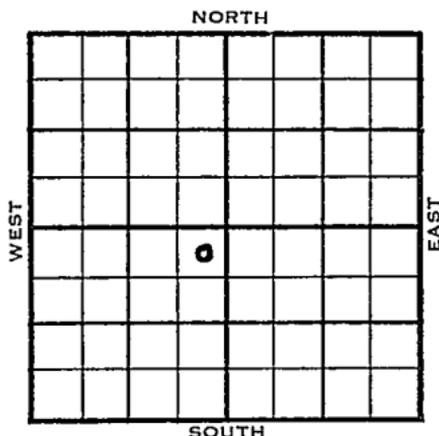

ELEVATION REPORT

1955 ~~2122~~ 1567'

3/16 Spud 3-11-55
8" @ 163'
Dr lg. 1910'

~~4/6 Spud 4-6-55, D&A, TD 4376
8" @ 270; Heeb 3608; Lans 3652
BKC 3938, Cherokee 4088,
DST 4073-4100, open 1 hr, Rec
1250' SW 1350#, DST 4100-12
open 1 hr, Rec 3000' SW, 1380#
Miss 4118, Misener 4217, Viola
4226, Simp 4309, Arb 4336,
TD 4376
D&A error~~

4/6 Spud 3-11-55, D&A, TD 2984
8" @ 163; Lans 2357, Cong 2972,
Miss 2980, TD 2984, 5" @ 2979
CO to 2984, FU 7 go 40 GW 16
hr. 500 A FU 60' oil 475' wtr
16 hr. FU 100' oil 900' wtr,
15 hr. S/6 be 1250 BW-3 hr
D&A

ABANDONED

County **McPherson** State **Kansas**

Sec. **9** (Blk. Twp.) **19** (Sur. Rge.) **2W** Map No.

Operator **E. K. Carey**

Well No. **1** Farm **Nelson**

Elev. Location **NE NE SW**

FIRST REPORT					
	/		o		
	/		/		

330 Ft. From **N** Line **SW**

330 Ft. From **E** Line **Quarter**

1st. Report **MAR 16 1955**

Completion

Remarks

Co. tools

Spudding Date **3-11-55**

Drlg. Data **Ritz-Canton Pool**

8" @ 163 drlg. 1910

FABEN GILSTRAP

County McPherson State Kansas
 Sec. 9 (Blk. Twp.) 19 (Sur. Rge.) 2W Map No.
 Operator E. K. Carey
 Well No. 1 Farm Nelson
 Elev. 1567 Location NE NE SW



330 Ft. From N Line SW
330 Ft. From E Line Quarter

Ist. Report

Completion APR 6 1955

Remarks Ritz-Canton Pool

Co. tools

Spudding Date 3-11-55

Drlg. Data D & A TD 2984

8" @ 163 -Lans. 2357 Cong. 2972

Miss. 2980 TD 2984 5" @ 2979 CO to

2984 FU 7 go 40 gw 16 hr. - 500 A

FU 60' oil 475' wtr. 16 hr.

FU 100' oil 2900' wtr. 15 hr.

S/ 6 bo 1250 bw 3 hr.

D & A

FABEN GILSTRAP