


McPherson

Form 252-A
5M 4-32 MPC

Map No. KANSAS Sec. 9 Twp 19 R. 2^W

Well No. 1 Jones Farm
Alley & Woodward Company

 Ft. from N. Line
990 Ft. from S. Line
330 Ft. from E. Line
 Ft. from W. Line

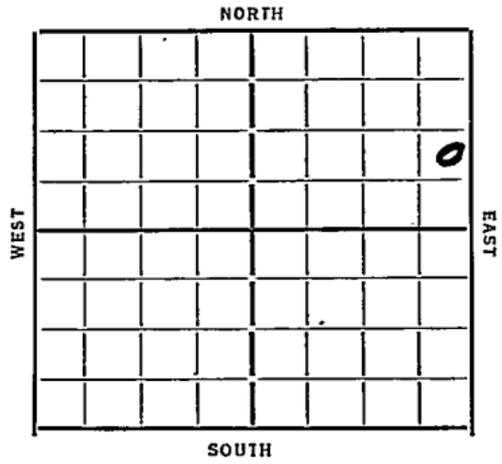

Date	REPORT
7/11	Location
7/19	— 7/26 — 8/2 — 8/9 —
8/16	— 8/23 —
8/30	B.R.
9/6	Rig
9/13	—
9/20	dy 320
9/27	" 650
10/4	10" 1065 C.O.
10/11	8" 1456 1515 W.R.
10/18	1705 dy
10/25	8" 1678 T) 1705 W.R.
11/1	1880 dy
11/8	8" 1693 dy 1880
11/15	dy 2278 HFW 2125
11/22	N.C. 2332 Pay 2339-42 500' fluid Run 698 2332
11/28	—
12/6	6" 2328 T) 2375 shut 20 Bbls 12 hrs.
12/13	1000 acid
12/21	30 Bbls per day OVER

12/27 T 7 2373
P 30 Bbls per day

1/3/35 1000 acid ..

1/20 cet 20 Bbls.

1/17 —

1/23 K. C. 2332 T 7 2375
1000 acid
19 Bbls oil
12 Water.

COMPLETED

KANSAS

Map No. 43 Sec. 9 Twp. 19 R. 2W

Well No. #1 - Jones

Alley & Woodward Company
Contractor

SECTION PLAT

			0

FIRST REPORTS

Ft. from N. Line

990 Ft. from S. Line

330 Ft. from E. Line

Ft. from W. Line

Location ✓

Rig up _____

Drilling and Remarks:

RECORD

Cased _____ in., _____ ft.

Sand _____

Gas _____

Oil _____

Total Depth _____

PRODUCTION

1st 24 hrs. Nat. _____

1st 24 hrs. after shot _____

Gas _____ Cu. Ft.

Dry Hole _____

Abandoned _____

Date

7-11-34 19

ORVAL MANNSCHRECK

Scout

make

RAH

WOL

Map No. 43 Sec. 9 Twp. 19 R. 2N

Well No. 1 - Jones

Alley & Woodard Company

Contractor

COMPLETED

SECTION PLAT

..... Ft. from N. Line
990 Ft. from S. Line
330 Ft. from E. Line
..... Ft. from W. Line

			0

Location

Rig up

Drilling and Remarks:

1000 and

*19 ft oil
12 water*

RECORD

Cased..... in., ft.

Sand *11.0, 2332*

Gas.....

Oil.....

Total Depth *2375*

PRODUCTION

1st 24 hrs. Nat.....

1st 24 hrs. after shot.....

Gas..... Cu. Ft.

Dry Hole.....

Abandoned.....

Date

1-23-35

192.....

ORVAL MANSCHRECK

Scout

