


Section 9 Township 19 Range 2W

Well No. #1 Severtson

Company Dezier Oil

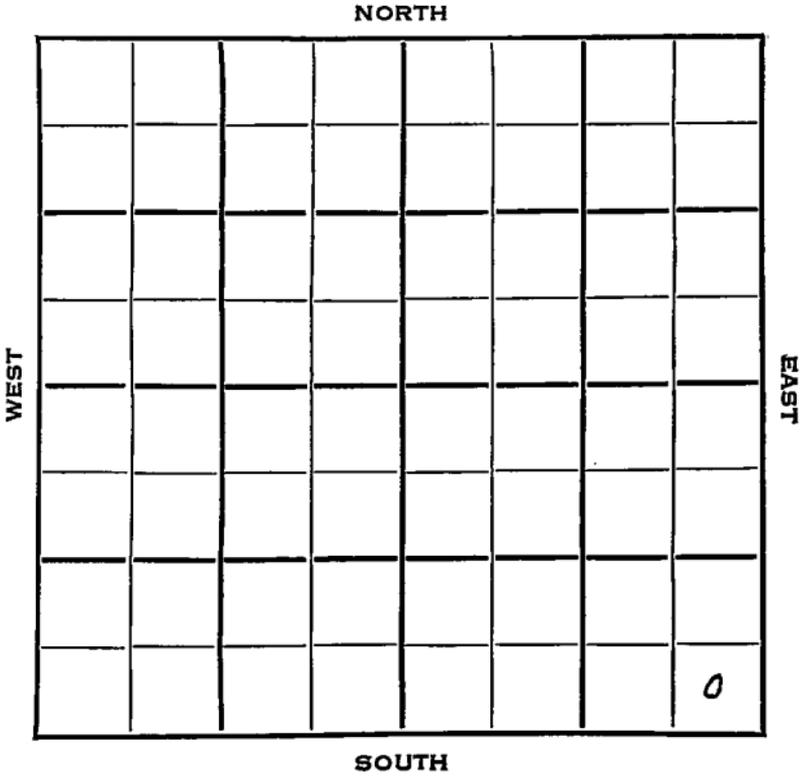

SEC.	TWP.	R.
9	19	2W


WELL NO. #1 Severtson FARM

COMPANY Dozier Oil

CONTRACTOR Stag Drlg.

Ritz-Canyon Pool

_____ Ft. from N. Line
 330 _____ Ft. from S. Line
 330 _____ Ft. from E. Line
 _____ Ft. from W. Line

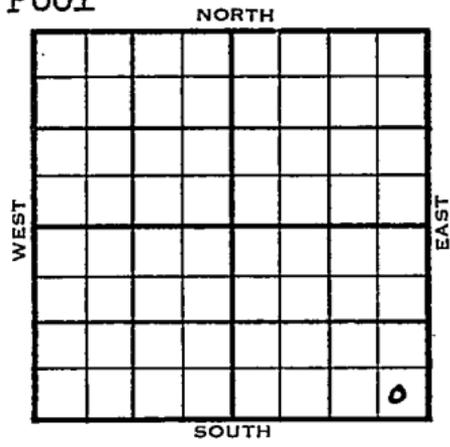

SE SE SE

	ELEVATION	REPORT
1954	1551'	
2/10	M I R	
2/17	8" @ 150'	
	KC 2327'	
	Drlg. 2722'	
2/24	Cong 2934', Miss 2941'	
	DST 2944'	
	5" @ 2942'	
	DD 2953', 750A	
	S/2 BFPH 50% wtr.	
	PB 2943', 46/2931-42, S/3 boph 15 hrs.	
	500A	
3/3	NR	
3/10	"	
3/17	Spud 2-9-54	
	OilWell	
	TD 2953'	
	8" @ 150'	
	KC 2327', Cong 2934', Miss 2941'	
	TD 2944'	
	5" @ 2942'	
	DD 2953 750 A S/ 2 bfph 50% Wtr.	
	PB 2943' 46/ 2931-42 S/ 3 boph 15 hr	
	500 A	
	Comp 30 bopd	

COMPLETED


County McPherson State Kansas

Sec. 9 (Blk. 19) (Sur. Rge.) 2W Map No.

Operator Dozier Oil

Well No. 1 Farm Severtson

Elev. 1551 Location SE SE SE

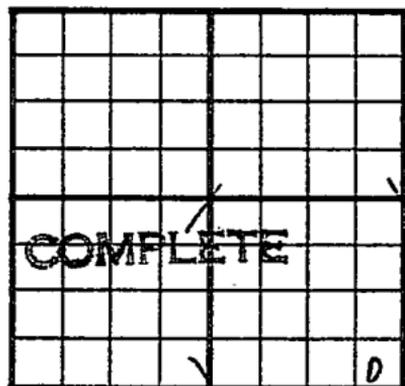

330 Ft. From S Line SE

330 Ft. From E Line Quarter

Ist. Report

Completion MAR 17 1954

Remarks Ritz-Canton Pool

Stag Drlg. - Contr.

Spudding Date 2-9-54

Drlg. Data Oil well TD 2953

8" @ 150 KC 2327 Cong. 2934

Miss. 2941 TD 2944 5" @ 2942

DD 2953 750 A S/ 2 bfph 50% wtr.

PB 2943 46/ 2931-42 S/ 3 boph 15 hr.

500 A Comp. 30 bopd