


McPherson

Form 51-5M-2-29-34703

Map No. KANSAS Sec. 9 Twp. 19 R. 2w

Well No. 1-Severtson Farm
Emrick et al Company

NORTH

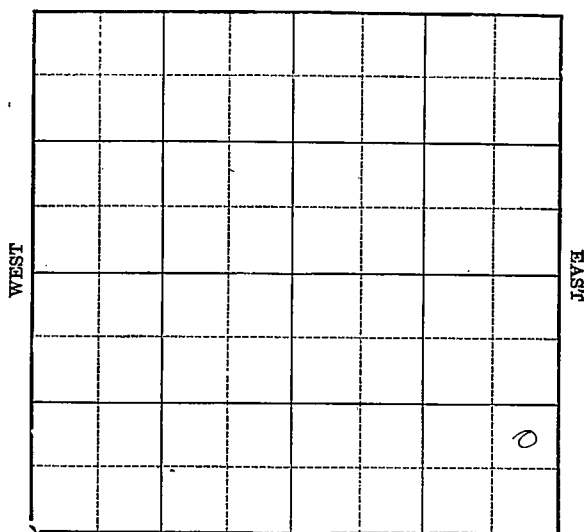

SOUTH

Location

Drilling Remarks

Rig Up

Drilling Remarks

RECORD

Cased in. ft.

Sand

Gas

Oil

Total Depth

PRODUCTION

1st 24 hrs. Nat.

1st 24 hrs. after shot

Gas cu. ft.

Dry Hole

Abandoned

Map No. KANSAS Sec. 9 Twp. 19 R. 2^w


Emuck et al Company

 Ft. from N. Line

990 Ft. from S. Line

330 Ft. from E. Line

1931 Ft. from W. Line

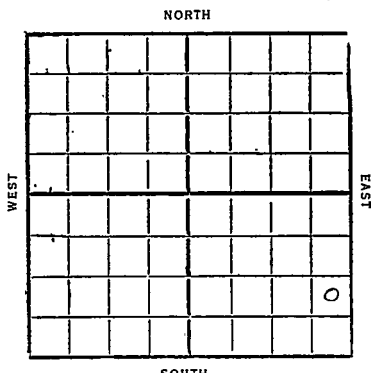

Date	REPORT
4/15	Bldg rig
4/22	Rig
4/29	
5/6	Rgn up
5/13	
5/20	Spdg
5/27	51 450'
6/3	drg 1225'
6/10	12"-1477
	HFW at 1480
	Drg 1507
6/17	12"-1508
	Drg 1700'
6/24	7 bailer water 1760-72
	10"-1800
	drg 1825'
7/1	10"-1900
	drg 2015
7/8	T.D. 2290' 4 1/2 10"
7/15	
7/22	10"-2346
	Drg 2415'

7/29- HFW 2425-35

Drilg 2620'

8/5- T.D. 2738' UIR 8"

8/12- Top chat 2941'

Am 6" csq

8/19- From 2947-48

Had spray oil
and 2 M gas

8/26- T.D. 2948'

No test

Erecting tankage

9/2- T.D. 2953' No test

9/9- T.D. 2958

Made 180 bbl 12 hrs

9/15- Chat 2941-58

T.D. 2958

flow 121 bbl 1st 24 hr

McPherson

43 KANSAS

Map No. _____ Sec. 9 Twp. 19 R. 2 W

Well No. 1 Severtson

Emrick et al Company

Contractor

FIRST REPORTS

_____ Ft. from N. Line

990 Ft. from S. Line

330 Ft. from E. Line

_____ Ft. from W. Line

SECTION PLAT

Location _____

Rig up Blog Rig

Drilling and Remarks:

RECORD

Cased _____ in., _____ ft.

Sand _____

Gas _____

Oil _____

Total Depth _____

PRODUCTION

1st 24 hrs. Nat. _____

1st 24 hrs. after shot _____

Gas _____ Cu. Ft.

Dry Hole _____

Abandoned _____


Date

APR 15 1931

192

CHAS. L. SHERWOOD

Scout

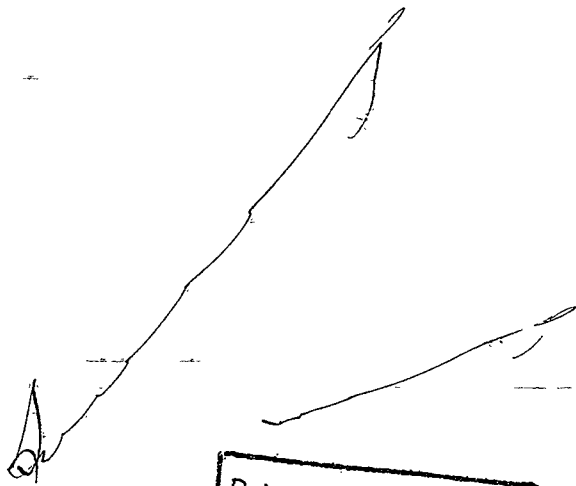

Returned	
Cards	<i>[Signature]</i>
Tracing	<i>[Signature]</i>
France Map	<i>[X]</i>
Scarborough Map	<i>[Signature]</i>
Moody Map	<i>[X]</i>
Scarborough Plat Book	<i>[Signature]</i>
Moody Plat Book	<i>[Signature]</i>

McPherson

KANSAS

Map No. _____ Sec. 9 Twp. 19 R. 2 ^WWell No. 43 1 SevertsonEmrick et al Company

Contractor

COMPLETED

_____ Ft. from N. Line

990 Ft. from S. Line330 Ft. from E. Line

_____ Ft. from W. Line

SECTION PLAT

			0

Location _____

Rig up _____

Drilling and Remarks:

Flow 121 lbs

187 24 hrs.

RECORD

Cased _____ in., _____ ft.

Sand Char 2941-2958

Gas _____

Oil _____

Total Depth 2958

PRODUCTION

1st 24 hrs. Nat. _____

1st 24 hrs. after shot _____

Gas _____ Cu. Ft.

Dry Hole _____

Abandoned _____


Date

SEP 16 1931

CHAS. L. SHERWOOD

192

Scout

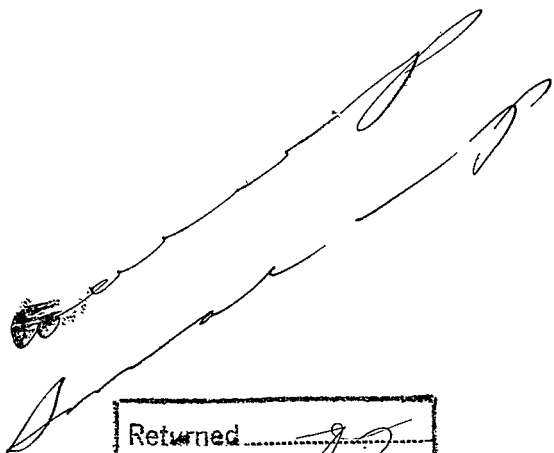

Returned	_____
Cards	_____
Tracing	_____
France Map	_____
Scarborough Map	_____
Moody Map	_____
Scarborough Flat Book	_____
Moody Flat Book	_____