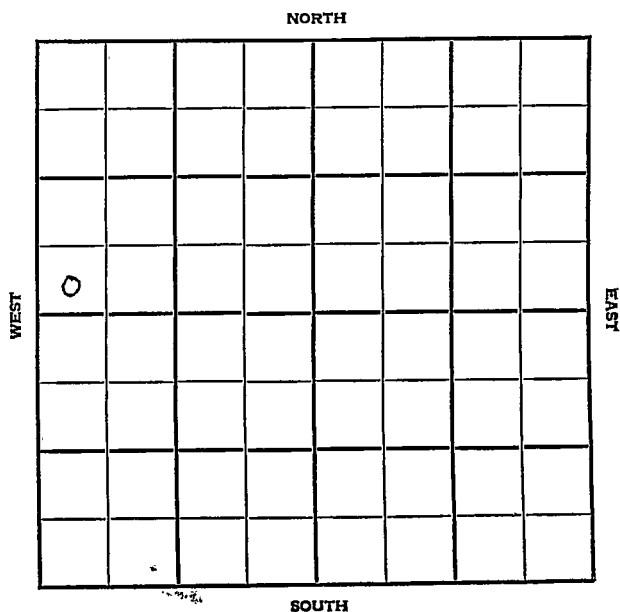



Section 9 Township 19 Range 11 WWell No. #1 ScolesCompany Northern Pump
Hilton Drig.

Barton KANSAS
 SEC. 9 TWP. 19- R. 14W

WELL NO. #1 Scoles FARM

COMPANY Hilton Drlg. Northern Pump.
 CONTRACTOR Co. Tools

Wildcat
 _____ Ft. from N. Line
 330 _____ Ft. from S. Line
 _____ Ft. from E. Line
 330 _____ Ft. from W. Line
 SW SW NW

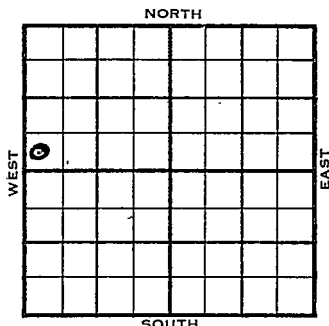

Skelly-DHM

1955	ELEVATION		REPORT
	1930		
8/3	Comm 7-29-55		FIRST REPORT
	8" @886/425	Drlg. 1537	
11/9	Comm 7-29-55		
	8" @ 886/425		
	Anh	875	876
	H	3166	3108
	Tr		3185
	Dg		3202
	B1	3254	3253
	L	3266	3264
	BKC		3492
	A	3528	3538
	TD	3615	
	DST 3269-86 open 1 hr rec 25' mud		
	385# DST 3314-42 open 1 hr rec 182'		
	o&gcm 100' ho & gcm 100' ho & GCM		
	200' wco 120' wtr 1250# DST 3313-		
	28 open 1 hr rec 80' muddy oil 0#		
	DST 3528-40 open 45 min, rec 20' mud		
	0# DST 3540-58 open 45 min rec		
	20' mud 0/20" 5 1/2" @ 3613/125		
	CO to 3580 54/3554-63 8 goph		
	750 A S/12 boph frac S/2 1/2 boph		
	24/3538-42 750A S/x S/6 bo PB		
	3530 36/3516-22 frac FU 1800'		
	fluid 5% oil sq perf 3516-22 CO		
	OVER OVER		

1955

11/9 CO to 3580 16/3538-42 600 A dry
neperf 27/3555-63 600 A S/11 bo
125 bw 8 hr FU 80' oil 2020'
wtr S/28 bf 12 bo 16 bw 49/3555-63
1 1/2 bo 45 min 600 A S/9 bo
12 bw 4 1/2 hr FU 350' oil 450' wbr
8 hr S/12 BO 16 hr P 11 bo
14 bw 24 hr P/8 bopd 16 bw
Comp 9 bopd 64% wtr

COMPLETED

DX-201

Kosten

SEC.

TWP.

R.

9

19

LiW

WELL NO.

7. Scores

FARM

COMPANY

Northern Pump

CONTRACTOR

CORRECTION

SW SW NW

NORTH

FT. FROM N. LINE

330

-FT. FROM S. LINE

FT. FORM E. LINE

330

FROM W. LINE

WEST

EAST

SOUTH

Barton County

LOCATION

RIG UP

DRILLING AND REMARKS:

Reported
Hilton Drlg.

RECORD

CASED IN., FT.

SAND

GAS

OIL

TOTAL DEPTH

1ST 24 HRS. NAT.

1ST 24 HRS. AFTER SHOT

[illegible]

DRY HOLE

ABANDONED

PRODUCTION

DATE _____

SEP

7 1955

SCOUT

P. J. Harris

County Barton Elev. _____
 Sec. 9 Twp. 19 Rge. 14W
 Company Hilton Drlg.
 FarmName Scoles No. 1

TOPS	DEPTH	LOG	DATUM	Loc. in Sec.
Anh.	875			SW SW NW
Tr.				
H.				
Tr.				
Dg.				
BL.				
L.				
K.C.				Geol.
B.K.C.				Contr.
Ce.				Co. tools
C.				Pool
M.				Wildcat
M.				
K.				
Mz.				
Me.				
V.				
S.				
S.				
A.				
R.				
Pe.				
G.				
T.D.				

FIRST REPORT
 AUG 3 1955

Date Comm. 7-29-55 Skelly - DHM
8" @ 886/425 drlg. 1537

10/3

County Barton Elev. 1930
 Sec. 9 Twp. 19 Rge. 14W
 Company Northern Pump
 FarmName Scoles No. 1

Co.

Lse.

No.

Sec.

T.

R.

TOPS	DEPTH	LOG	DATUM	Loc. in Sec.
Anh.	875	876		SW SW NW
Tr.				
H.	3166	3108	1178	
Tr.		3185	1255	
Dg.		3202	1272	
Bl.	3254	3253	1323	
L.	3266	3264	1334	
K.C.				Geol.
B.K.C.		3492	1562	Contr.
Ce.				Co. tools
C.				
M.				Pool
M.				Wildcat
K.				
Mz.				
Ma.				
V.				
S.				
S.				
A.	3528	3538	1608	
R.				
Pe.				
G.				
TR.	3615			


COMPLETE

Date Comm. 7-29-55 NOV 9 1955

8" @ 886/425 DST 3269-86 open 1 hr.
 rec. .25' mud 385# DST 3314-42 open
 1 hr. rec. 182' o & gcm 100' ho & gcm
 200' wco- 120' wtr. 1250# DST 3313-28
 open 1 hr. * rec: 80' muddy oil 0#
 DST 3528-40 open 45 min. rec. 20' mud
 0# DST-3540-58 open 45 min. rec.
 20' mud 0/20" 5 1/2" @ 3613/125

OVER

C0 to 3580 54/ 3554-63 8 goph
 750 A S/ 12 boph frac S/ 2 $\frac{1}{2}$ boph
 24/ 3538-42 - 750 A S/ 6 bo PB 3530
 36/ 3516-22 frac FU 1800' fluid
 5% oil sq. perf; 3516-22 C0 to 3580
 16/ 3538-42 600 A dry reperf
 27/ 3555-63. 600 A S/ 11 bo 125 bw
 8 hr. FU 80' oil 2020' wtr.
 S/ 28 bf 12 bo 16 bw 49/ 3555-63 .
 1 $\frac{1}{2}$ bo 45 min. 600 A S/ 9 bo
 12 bw 4 $\frac{1}{2}$ hr. FU 350' oil 450' wtr.
 8 hr. S/ 12 bo 16 bw
 P/ 11 bo 14 bw 24 hr. P/ 8 bopd 16 bw
 Comp. 9 bopd 64% wtr.

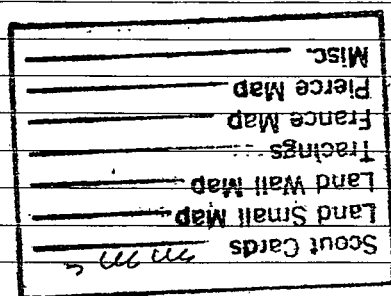

NOV 17 1955

SCOUT TICKET

DX-201

SEC.

TWP.

R.

9

19

14W

WELL NO.

1 Scoles

FARM

COMPANY

Northern Pump

CONTRACTOR

CORRECTION

SW SW NW

____ FT. FROM N. LINE

330

____ FT. FROM S. LINE

____ FT. FORM E. LINE

330

____ FT. FROM W. LINE

NORTH

WEST

EAST

SOUTH

Barton County

☐

LOCATION

☐

RIG UP

DRILLING AND REMARKS:

Reported
Hilton Drlg.

RECORD

CASED IN., FT.

SAND

GAS

OIL

TOTAL DEPTH

1ST 24 HRS. NAT.

1ST 24 HRS. AFTER SHOT

GAS CU. FT.

DRY HOLE

ABANDONED

PRODUCTION

DATE

NOV 9 1955

SCOUT