


Section 9 Township 19 Range 14 W

Well No. #2 Scoles

Company Norther Pump

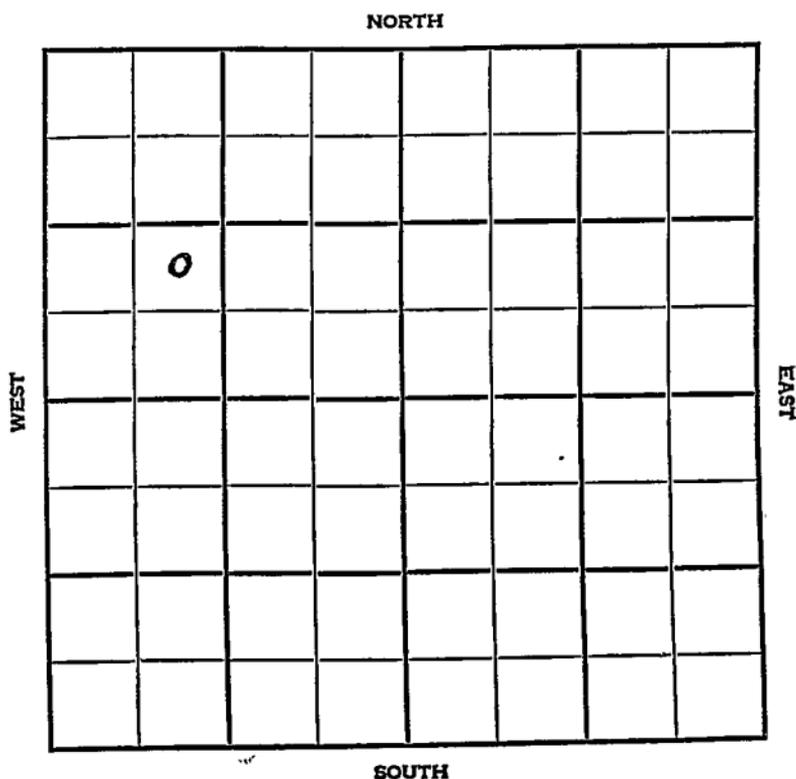

SEC. 9	TWP. 19	R. 11W
-----------	------------	-----------

WELL NO.

#2 Scoles

FARM

COMPANY

Northern Pump

CONTRACTOR

Hilton


N. Heizer

\_\_\_\_\_ Ft. from N. Line

\_\_\_\_\_ Ft. from S. Line

\_\_\_\_\_ Ft. from E. Line

\_\_\_\_\_ Ft. from W. Line

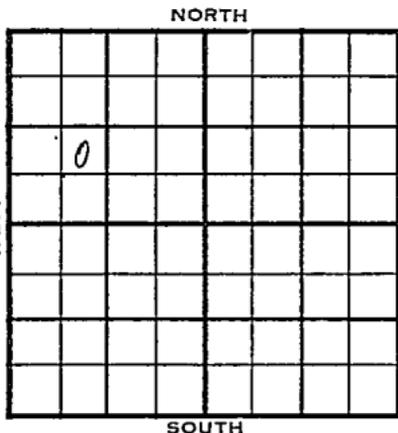

NE SW NW

1956	ELEVATION	REPORT
------	-----------	--------

2-15 Comm. 2-11-56  
 8" @ 866/425  
 Drlg. @ 1215

County Barton Elev. \_\_\_\_\_  
 Sec. 9 Twp. 19 Rge. 11W  
 Company Northern Pump  
 FarmName Scoles No. 2

TOPS	DEPTH	LOG	DATUM	Loc. in Sec.
Anh.				NE SW NW
Tr.				
H.				
Dg.				
Bl.				
L.				Geol. _____
K.C.				Contr. _____
B.K.C.				
Ce.				<u>Hilton</u>
C.				
M.				Pool _____
M.				<u>N. Heizer</u>
K.				
Mz.				
Mo.				
V.				
S.				
S.				
A.				
R.				
PE.				FIRST REPORT
G.				
T.D.				FEB 15 '56

Date Comm. 2-11-56  
8" @ 866/425 drlg. 1215

~~1/3~~

Co.  
Lse.  
No.  
Sec.  
T.  
R.

County Barton Elev. 1907  
 Sec. 9 Twp. 19 Rge. 11W  
 Company Northern Pump  
 Farm Name Scoles No. 2

TOPS	DEPTH	LOG	DATUM	Loc. in Sec.
Asb.				NE SW NW
Tr.				
H.	3148			
Tr.	3166			
Dg.	3184			
Bl.	3236		1339	
L.	3245		1338	Geol.
K.C.				Contr.
B.K.C.				
Ce.				
C. <u>3h</u>	3474		1567	Hilton
M.				
M.				Pool
K.				<u>N. Hager</u>
Me.				
Mo.				
V.				
S.				
S.				
A.	3559		1652	ABANDONED
R.				
PC.				
G.				
TR.	3609			

Date Comm. 2-11-56 FEB 29 1956

8" @ 866/125 drlg. 1215 FEB 22 56

DST 3070-3114 30" rec 20'  
 Md (sps oil) BHP 900/20  
 DST 3296-3307 30" rec  
 12' Md all press & DST 3382  
 -90 lbs 90' BHP rec 30' oil  
 GCM TRWH BHP 200/20 DST  
 3395-3412 30" rec 20' Md  
 all press & @ 3440