


Section 9 Township 19 Range 32W

Well No. #1 Joe E. Kinzel

Company Harbar Drlg.

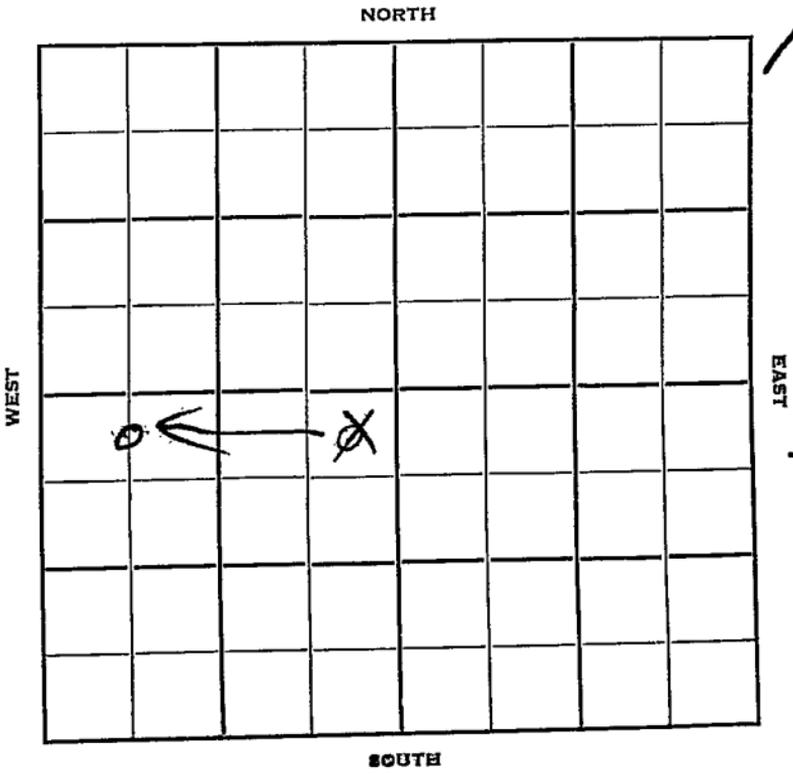

Sec. 9 Twp. 19 R. 32W

Well No. #1 Joe E. Kinzel Farm

Harbar Drlg. Company

Harbar Drlg. - Contr. Contractor

Wildcat

330' Ft. from N. Line


_____ Ft. from S. Line

~~480'~~ Ft. from E. Line

660 Ft. from W. Line

~~NE NE SW~~

C N L N W S W

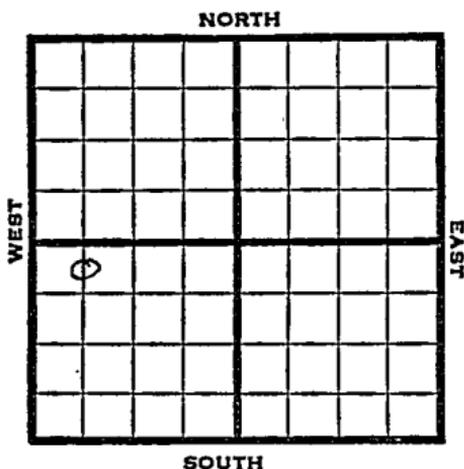

1950 Elev. 2947' REPORT

8/30 Drlg. 4000'

11/8 D&A TD 4915'

Anhy 2291' Hol. 2708'

Her. 2732' Krider 2746'

Win. 2782' Towanda 2846'

Ft. Riley 2870' Florence 2953'

Breford 3014' Neva 3200'

Tarkio 3510' Howard 3680'

Heeb. 3907' Toronot 3920'

Lans. 3950' Drum 4148'

BKG 4334' Cherokee 4481'

Miss Lime 4669-4915 TD

D&A

ABANDONED

Map No. _____ Sec. 9 Twp. 19 R. 32WWell No. 1 Joe E. Kinzel

_____ Harbar Drlg. _____ Company

_____ **CORRECTION** _____ Contractor

C N L NW SW

SECTION PLAT

330 Ft. from N. Line

_____ Ft. from S. Line

_____ Ft. from E. Line

660 Ft. from W. Line

o			

Scott County

Location _____

Rig up _____

Drilling and Remarks:

Reported

NE NE SW

RECORD

Cased _____ in., _____ ft.

Sand _____

Gas _____

Oil _____

Total Depth _____

PRODUCTION

1st 24 hrs. Nat. _____

1st 24 hrs. after shot _____

Gas _____ Cu. Ft.

Dry Hole _____

Abandoned _____

Date

OCT 4 1950 19 J. E. TYRA Scout

