

KANSAS

Barton

Section 9 Township 19 Range 15W

Well No. 1 Hanken

Company Ferrell Drlg.

Mertens
NORTH

0							

WEST

EAST

SOUTH

KANSAS

Barton

Sec. 9 Twp. 19 R. 15W

Well No. 1 Hanken Farm

Ferrell Drlg. Company


Mertens Pool Ferrell Drlg. - Contr.

330 Ft. from N. Line

_____ Ft. from S. Line

_____ Ft. from E. Line

330 Ft. from W. Line

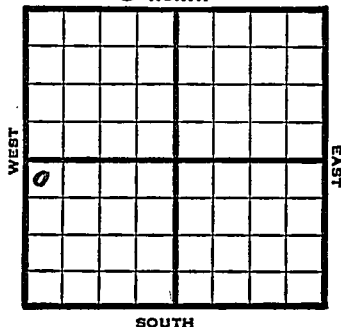

NW SW

1949 Elev 1974' REPORT

9/28 Anhy 957
8" @ 961'
Drlg. 2005

10/5 Lansing 3279'
Reagan 3588'
Drlg 3593'

10/12 TD 3593'
5" @ 3589'

10/19 TD 3599'
SO&W

10/26 "

11/1 "

11/9 "

11/23 TD 3599'
Reagan 3588'
5 @ 3589'
Pump 50 Oil / 50 W Pot
36° Gr.
Comp

COMPLETED

Map No. _____ Sec. 9 Twp. 19 R. 15W

Well No. 1 Hanken

Ferrell Drlg. Company

Ferrell Drlg. Contractor

NW SW

FIRST REPORT
SECTION PLAT

330 Ft. from N. Line

_____ Ft. from S. Line

_____ Ft. from E. Line

330 Ft. from W. Line

Barton County

Location _____

Rig up _____

Drilling and Remarks:

Anhy 957

8" @ 961

drlg. 2015

RECORD

Cased _____ in., _____ ft.

Sand _____

Gas _____

Oil _____

Total Depth _____

PRODUCTION

1st 24 hrs. Nat. _____

1st 24 hrs. after shot _____

Gas _____ Cu. Ft.

Dry Hole _____

Abandoned _____

Date

SEP 28 1949 19

S. J. LEWIS Scout

Map No. _____ Sec. 9 Twp. 19 R. 15W

Well No. 1 Hanken

Ferrell Drlg. Company

COMPLETE

Contractor

NW SW

E11974
SECTION PLAT

330 Ft. from N. Line

_____ Ft. from S. Line

_____ Ft. from E. Line

330 Ft. from W. Line

6			

Barton County

Location _____

Rig up _____

Drilling and Remarks:

Reagan 3588
5" 203589

Prod 50 oil + 50 W
P.O.T.

36 3/4

RECORD

Cased _____ in., _____ ft.

Sand _____

Gas _____

Oil _____

Total Depth 3599

PRODUCTION

1st 24 hrs. Nat. _____

1st 24 hrs. after shot _____

Gas _____ Cu. Ft.

Dry Hole _____

Abandoned _____

Date

NOV 23 1949 19

S. J. LEWIS Scout