


Section 9 Township 19 Range 15W

Well No. 2 Hankens (Hanken)

Company M&L Oil ?

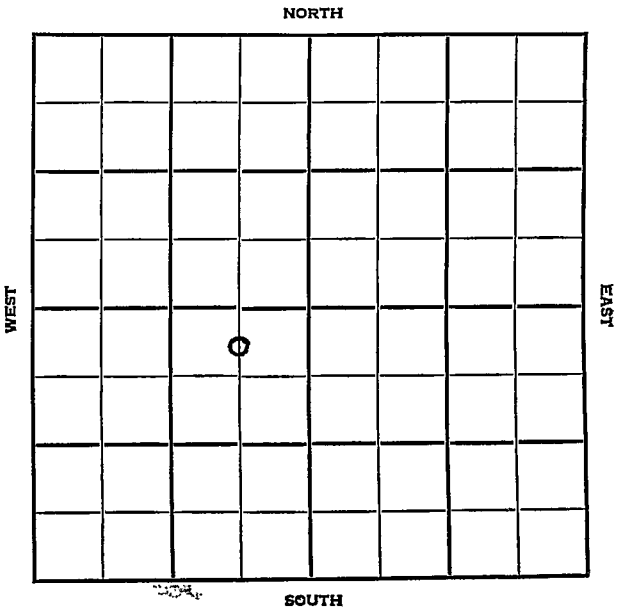

Barton

KANSAS



| | | |
|------|------|-----|
| SEC. | TWP. | R. |
| 9 | 19 | 15W |

WELL NO.

2 Hankens

FARM

COMPANY

M & L Oil

CONTRACTOR

Fleming & Woodman- Contr


330 Ft. from N. Line

Ft. from S. Line

660 Ft. from E. Line

Ft. from W. Line

CN $\frac{1}{2}$ NE SW

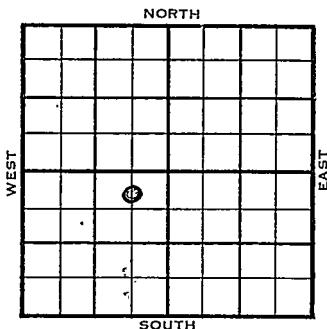

1954

ELEVATION

1959

REPORT

6/2

MIR

6/9

8" @ 941'
rlg. 2540'

6/23

Heeb 3198'; Tor 3211'; Br li 3270';
Lans 3283'; B KC 3484'; Cong 3522';
Reagan 3573'
RTD 3574'
5" @ 3573'

6/30

DD 3585' 1/4 GOPH Hyd.

7/21

NR

7/28

Spdg 6-2-54

Oil well

TD 3585

8" @ 941

Heeb 3198 Tor. 3211 Br.lime 3270

Lans. 3283 BKC 3484 Cong. 3522

Reagan 3573

TD 3574

5" @ 3573 DD 3585 1/4 goph Hydro

Comp. 50 bopd 150 bw

COMPLETED

County Barton State Kansas

Sec. 9 (Blk.) 19 (Sur. Rge.) 15W Map No.

Operator M & I Oil

Well No. 2 Farm Hankens

Elev. Location C N $\frac{1}{2}$ NE SW

| | | | | | |
|--------------|--|--|--|--|--|
| | | | | | |
| | | | | | |
| FIRST REPORT | | | | | |
| | | | | | |
| | | | | | |
| | | | | | |
| | | | | | |
| | | | | | |
| | | | | | |
| | | | | | |

330 Ft. From N30 Line SW

660 Ft. From E Line Quarter

Ist. Report JUN 2 1954

Completion

Remarks

Fleming & Woodman - Contr

Spudding Date

Drlg. Data

M I R

