


Barton KANSAS

DX 78-1

Section 9 Township 19 Range 15W

Well No. 3 Henken

Company M & H Oil

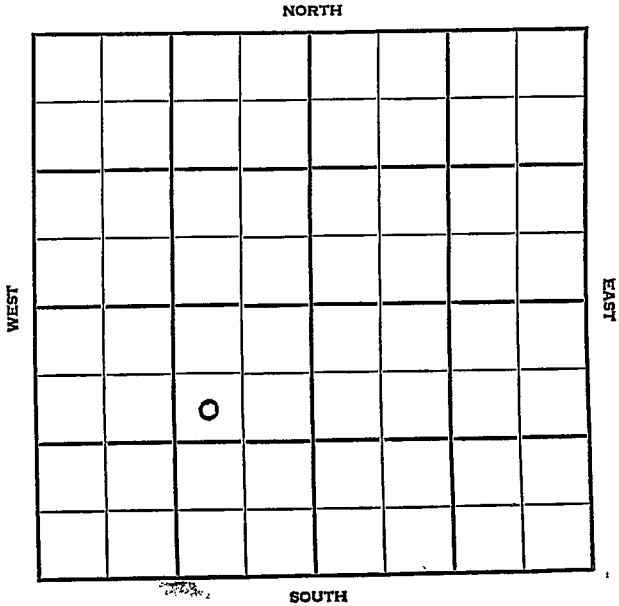

Barton KANSAS

SEC.	TWP.	R.
9	19	15W

WELL NO. 3 Hanken FARM

COMPANY M & L Oil

CONTRACTOR Fleming & Woodman


Otis-Albert Pool

990 Ft. from N. Line

Ft. from S. Line

990 Ft. from E. Line

Ft. from W. Line

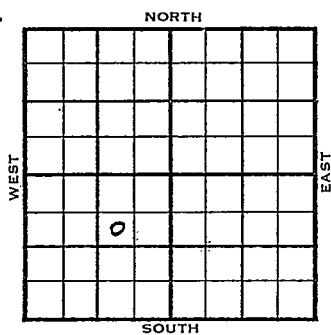

SW NE SW

	ELEVATION	REPORT
1954	1959'	

7/28 Spdg 7-24-54  
8" @ 942  
Anhy 935  
WOC

8/25 Spud 7-24-54 - OilWell  
TD 3595'  
8" @ 942'  
Anhy 935', Anhy 935', Heeb 3197',  
ans 3282', Cong 3531', Arb. 3567'  
TD 3595'  
5" @ 3584'  
CO to 3595'  
B/1 bo 1 bw  
Sd-frac  
Comp. 30 bopd 30 bw

COMPLETED



