


DX 78-1 Barton

KANSAS

Section 9 Township 19 Range 15W

Well No. #5 Hanken

Company M & L Oil

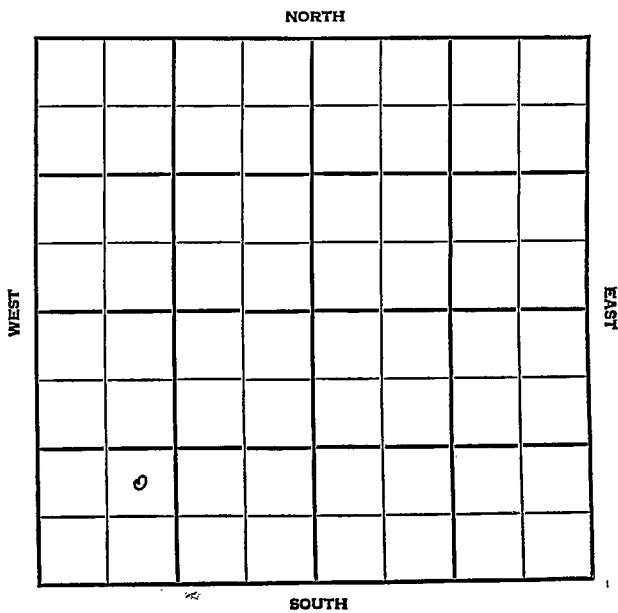

Barton KANSAS

SEC.	TWP.	R.
9	19	15W

WELL NO.

5 Hanken

FARM

COMPANY

M & L Oil

CONTRACTOR

Fleming & Woodman


Otis-Albert Pool

2 Ft. from N. Line

990 Ft. from S. Line

Ft. from E. Line

990 Ft. from W. Line

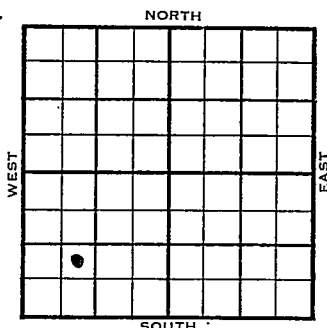

NE SW SW

1954	ELEVATION	REPORT
	1961'	


11/3 Spud 10-31-54
8" @ drlg. 1750'

12/8 Spud 10-31-54
Oil Well
TD 3582'
Anhy 935'
8" @ 939'
Heeb 3193' Br. Lime 3267', Lans 3279
Reagen 3564'
TD 3567'
5" @ 3565'
DD 3582' S/ 10 goph frac. S/ 25
boph
Comp 25 bopd. 50 bw.

COMPLETED

FABEN GILSTRAP

County Barton State Kansas
 Sec. 9 (Blk. 19) (Sur. 15W) Map No. 15W
 Operator M & L Oil
 Well No. 5 Farm Hanken
 Elev. 1961 Location NE SW SW

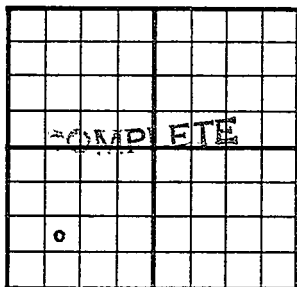

990 Ft. From S Line SW

990 Ft. From W Line Quarter

1st. Report

Completion DEC 8 1954

Remarks Otis-Albert Pool
Fleming & Woodman - Contr.

Spudding Date 10-31-54

Drilg. Data Oil well TD 3582
Anhy 935 8" @ 939 Heeb. 3193
Br. lime 3267 Lens. 3279 Reagen 3564
TD 3567 5" @ 3565 DD 3582 S/ 10 goph
frac S/ 25 boph Comp. 25 bopd 50 bw

FABEN GILSTRAP