


Section 9 Township 19 Range 15W

Well No. #6 Hanken

Company M & L Oil

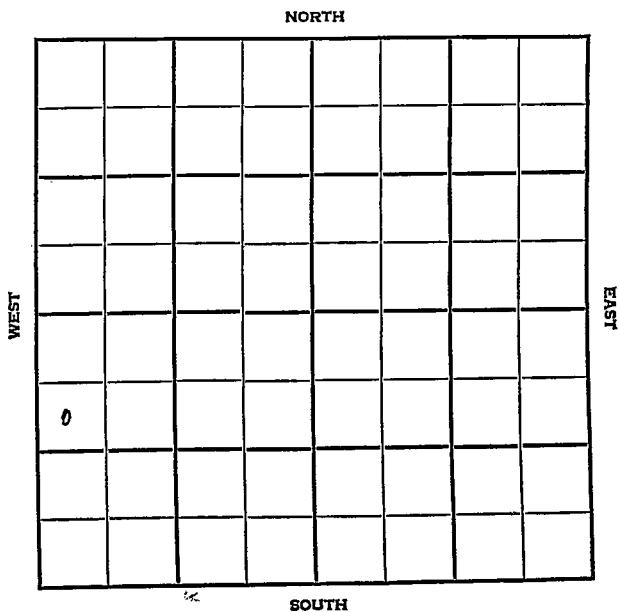

Barton KANSAS

SEC.	TWP.	R.
9	19	15W

WELL NO.

6 Hanken

FARM

COMPANY

M & L Oil

CONTRACTOR

Fleming & Woodman


Otis-Albert Pool

990 \_\_\_\_\_ Ft. from N. Line

\_\_\_\_\_ Ft. from S. Line

\_\_\_\_\_ Ft. from E. Line

330 \_\_\_\_\_ Ft. from W. Line

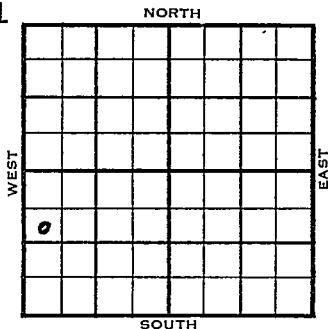

SW NW SW

1954

ELEVATION  
1973'

REPORT

11/23

RUR

1955

1/5

Spud 11-27-54

Oil Well

TD 3589'

8" @ 945'

Anhy 936', Doug 3239' Heeb 3207',

Br. Lime 3282', Lans 3293' Reagan 3585'

TD 3588'

5" @ 3587'

DD 3589' B/ 26 go 1 hr. sd-frac.

S/ 45 bopd. 70% Wtr.

Comp 25 bopd. 20 bw.

**COMPLETED**



