

Barton

DX 78-1


KANSAS

Section 9 Township 19 Range 15W

Well No. #1 Hanken "B"

Company M. & I. Oil Co.

NORTH

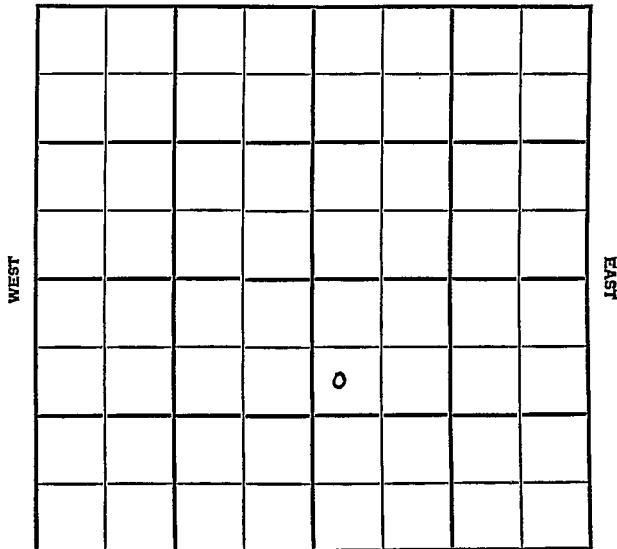

SOUTH

SEC.	9	TWP.	19	R.	15W
------	---	------	----	----	-----

WELL NO.

#1 Hanken "B"

FARM

COMPANY

M &amp; L Oil Co.

CONTRACTOR

Fleming &amp; Woodman Drlg.

Otis-Albert Pool

NORTH


990 Ft. from N. Line

Ft. from S. Line

Ft. from E. Line

330 Ft. from W. Line

SW NW SE

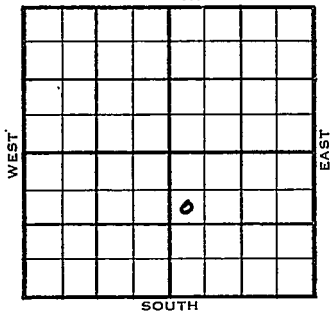

	ELEVATION	REPORT
1954	1952' DF	

9/22 Spud 9-17-54

8" @ 934'

Anhy

Drlg. 1565'

10/27 Spud 9-17-54

SWD Well.

TD 3587'

8" @ 934'

Heeb 3195', Doug 3225', Br. Lime 3261'

Lans 3280', B KC 3482', Cong 3544'

Reagan 3578'

TD 3579'

5" @ 3578'

DD 3587'

S/ 13 gfph 25% Wtr.

sd-frac. HFW

PB 3495'

11/ 3349-71, 1000 A 48 bw 10 min

Comp for SWD Well

ABANDONED



