


Section 9 Township 19 Range 15W

Well No. #1 S.A. Hanken

Company Champlin Ref.

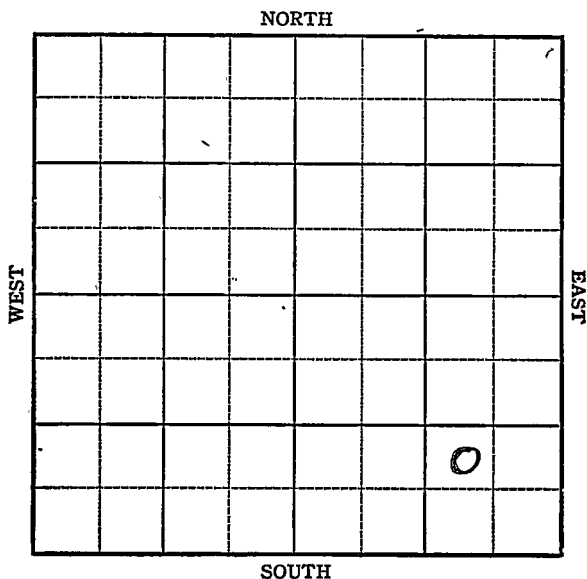

Sec. 9 Twp. 19 R. 15W

Well No. #1 S.A. Hanken Farm

Champlin Ref. Company

Wildcat


 Ft. from N. Line

990 Ft. from S. Line

940 Ft. from E. Line

 Ft. from W. Line

illed. 1943

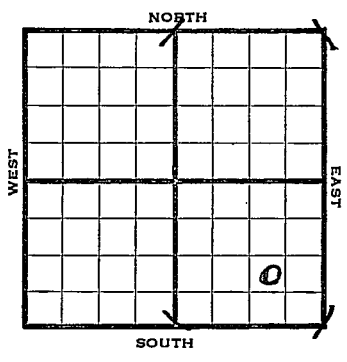

1944

REPORT

4/12 Derrick

4/19 15" @ 97
Drlg. 400'

4/26 Anhy 942
Drlg. 12151

5/3 10" @ 918
Drlg. 3130

5/10 Lans 3258
Arb. 3563
Granite Wash 3620
TD 3659

ABANDONED

