


Section 9 Township 19 Range 15-W w

Well No. #2 Miller

Company Rex & Morris

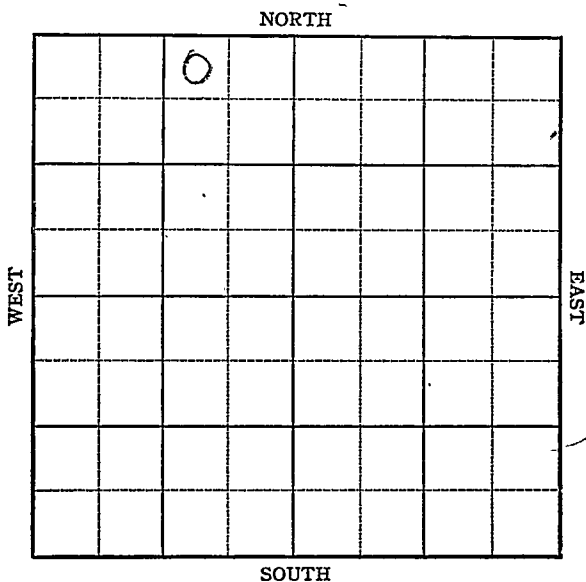



Sec. 9 Twp. 19 R. 15W

Well No. #2 Miller Farm

Rex & Morris Company


Mertens

330 Ft. from N. Line

_____ Ft. from S. Line

990 Ft. from E. Line

_____ Ft. from W. Line

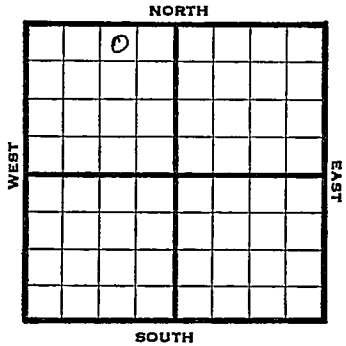

NW NE NW

1946 Elev. 1961' REPORT

7/31 RUR

8/6 Anhy 938'
8" @ 945
Drlg 1250'

8/13 Drlg 3430'

8/20 Lans 3262
Reagan 3539
3540 TD
5" @ 3540 RUST

8/27 TD 3573
HFO in 8 hrs

9/5 TD- 3593 swb 25 oil in 8 hrs

9/11 Reagan 3539'
5" @ 3540'
TD 3593'
Flow 303 Pot
Grav. 37

COMPLETED!

KANSAS Kansas Pool Name Mertens

Map No. _____ Sec. 9 Twp. 19 R. 15W

Well No. 2 Miller

Rex & Morris Company

FIRST REPORT Contractor

NW NE NW

SECTION PLAT

330 Ft. from N. Line

_____ Ft. from S. Line

990 Ft. from E. Line

_____ Ft. from W. Line

	o		
		.	

Barton County

Location _____

Rig up _____

Drilling and Remarks:

R U R

RECORD

Cased _____ in., _____ ft.

Sand _____

Gas _____

Oil _____

Total Depth _____

PRODUCTION

1st 24 hrs. Nat. _____

1st 24 hrs. after shot _____

Gas _____ Cu. Ft.

Dry Hole _____

Abandoned _____

Date

JUL 3 1 1946 19

S. J. LEWIS Scout

Kansas Pool Name Mertens PoolMap No. 82 Sec. 9 Twp. 19 R. 15WWell No. 2 MillerRex & Morris Company**COMPLETED**

Contractor

NW NE NW

E. 1961
SECTION PLAT330 Ft. from N. Line

_____ Ft. from S. Line

990 Ft. from E. Line

_____ Ft. from W. Line

	0		

Barton County

Location _____

Rig up _____

Drilling and Remarks: •

Reagan 0539
Loc 3540
Fluo 303 Bx

0798**RECORD**

Cased _____ in., _____ ft.

Sand _____

Gas _____

Oil _____

Total Depth 0598**PRODUCTION**

1st 24 hrs. Nat. _____

1st 24 hrs. after shot _____

Gas _____ Cu. Ft.

Dry Hole _____

Abandoned _____

Date

SEP 1 1 1946 19S. J. LEWIS Scout