
FORM 51

Barton KANSAS

Section 9 Township 19 Range 15W

Well No. 11 Miller

Company ~~Rex & Morris~~

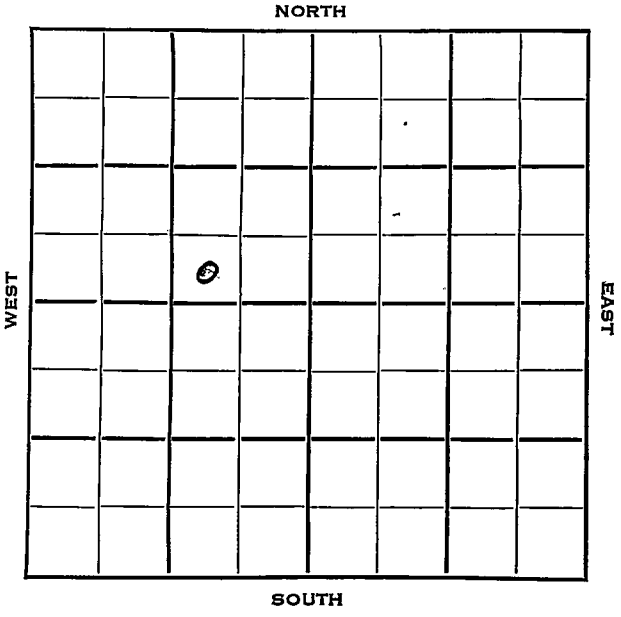

Barton KANSAS

SEC.	TWP.	R.
9	19	15W

WELL NO.

11 Miller FARM

COMPANY

Rex & Morris

CONTRACTOR

Rex & Morris
Otis-Albert Pool


_____ Ft. from N. Line

330 Ft. from S. Line

990 Ft. from E. Line

_____ Ft. from W. Line

SW SE NW

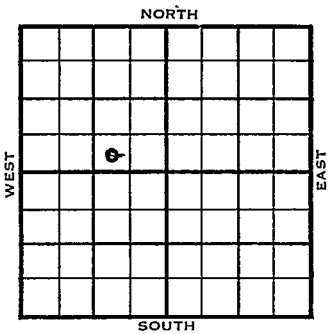

1954	ELEVATION 1964'	REPORT
2/17		RUR
2/24		Anhy 949' 8" @ 949' Drlg. 3214'
3/3		Heeb 3201', Lans 3284', B KC 3513', Cong 3536', Reagan 3572' RTD 3676' 5" @ 3573'
3/10		WOCT
3/17		"
3/24		"
4/7		"
5/5		"
5/12		"
5/19		Spud 2-15-54 Oil well TD 3580' Anhy 949 8" @ 949 Heeb 3201' Lans. 3284 B KC 3201 Cong 3536 Reagan 3572 TD 3576 5" @ 3573 DD 3580 7 BOPH 6 hr. Comp. 35 BOPD **COMPLETED**

DX-78

FORM 275 FOR SALE BY KANSAS BLUE PRINT CO.


County Barton State Kansas

Sec. 9 (Blk. Twp.) 19 (Sur. Rge.) 15W Map No.

Operator Rex & Morris

Well No. 11 Farm Miller

Elev. Location SW SE NW

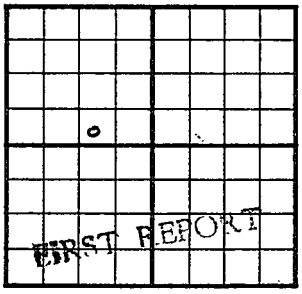

330 Ft. From S Line NW

990 Ft. From E Line Quarter

1st. Report FEB 17 1954

Completion

Remarks Rex & Morris - Contr.

Spudding Date

Drlg. Data Otis-Albert Pool

R U R

J. G. McGEHEE

FORM 275 FOR SALE BY KANSAS BLUE PRINT CO.


County Barton State Kansas

Sec. 9 (Blk. Twp.) 19 (Sur. Rge.) 15W Map No.

Operator Rex & Morris

Well No. 11 Farm Miller

Elev. 1964 Location SW SE NW

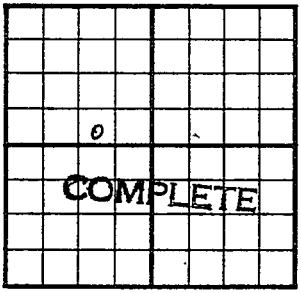

330 Ft. From S Line NW

990 Ft. From E Line Quarter

1st. Report

Completion MAY 19 1954

Remarks Otis-Albert Pool

Rex & Morris - Contr.

Spudding Date 2-15-54

Drlg. Data Oil well TD 3580

Anhy 949 8" @ 949 Heeb. 3201

Lans. 3284 B KC 3201 Cong. 3536

Reagan 3572 TD 3576 5" @ 3573

DD 3580 7 boph 6 hr. Comp. 35 bopd

J. G. McGEHEE