


DX 78-1

Rush KANSAS

Section 9 Township 19<sup>n</sup> Range 20W

Well No. 1 Young "C"

Company Republic Nat. Gas & Natural G&O

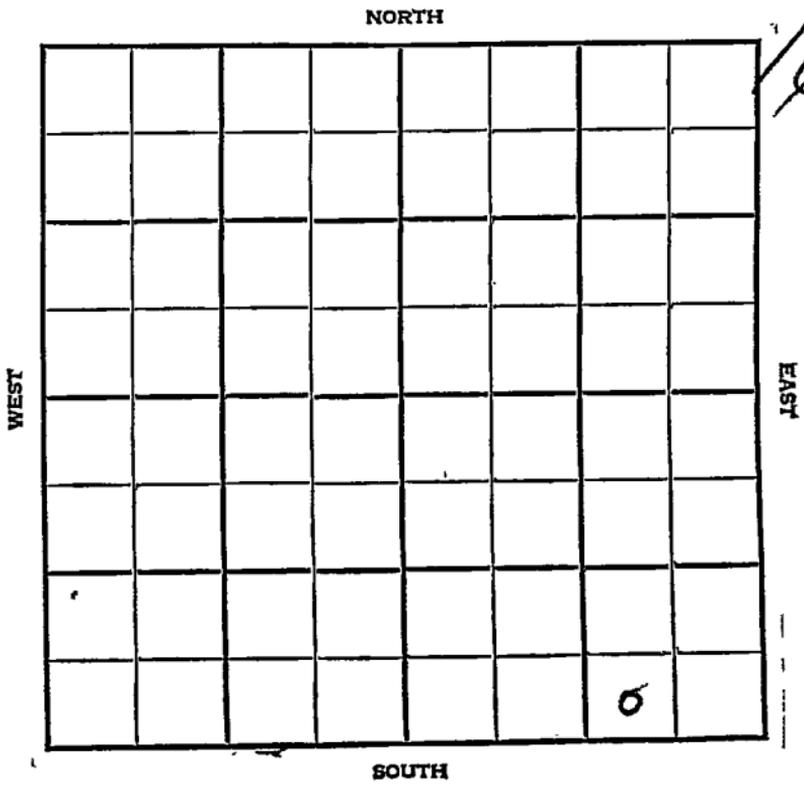

Rush KANSAS


SEC. 9 TWP. 19 R. 20 W

WELL NO. # 1 Young "C" FARM

COMPANY Republic Nat. Gas & Natural G & O

CONTRACTOR Co. tools

\_\_\_\_\_ Ft. from N. Line  
 330 \_\_\_\_\_ Ft. from S. Line  
 990 \_\_\_\_\_ Ft. from E. Line  
 \_\_\_\_\_ Ft. from W. Line

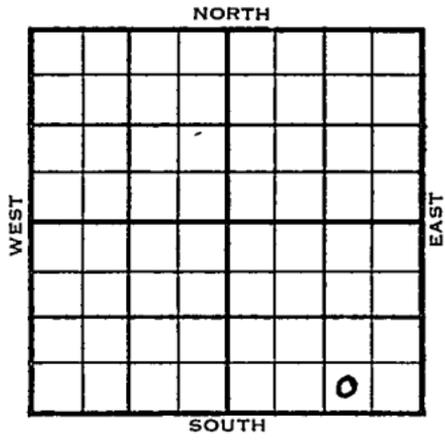

SW SE SE

1955	ELEVATION REPORT
2/2	2198' RJR
4/13	Spud 2-1-55 - Oil Well TD 4310' Anhy 1417', Heeb. 3697', Lans. 3741', Cherokee 4220' DST 4212-22', opn 1 hr., rec. 3668' oil, 8" @ 190' Miss. 4281' Schl Tops: Heeb. 3692', Lans. 3736', Cherokee 4210', Miss 4281' TD 4310' 5" @ 4309' CO, 12/4210-12, S/20 boph 30 bw P/37 b opd 163 bw Comp. 49 bopd 85% wtr.

COMPLETED



