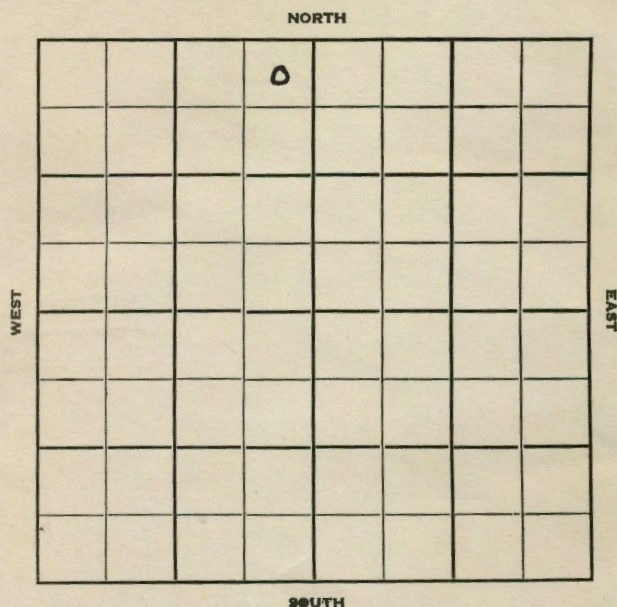


KANSAS

Phillips

Section 2 Township 1 Range 18-WWell No. #1 CaswellCompany Stableford & K & E Drlg.

3

KANSAS

HOT FILE

Phillips Co.

Sec. 2 Twp. 1S R. 18W ✓Well No. #1 Arthur Caswell FarmK & E Drilling Inc. CompanyK & E Drlg. Contr. Contractor

MCPC farmout NW/4

330' Ft. from N. Line


Ft. from S. Line

330' Ft. from E. Line

Ft. from W. Line

MCPC 1/16 of 7/8 override

NE NE NW

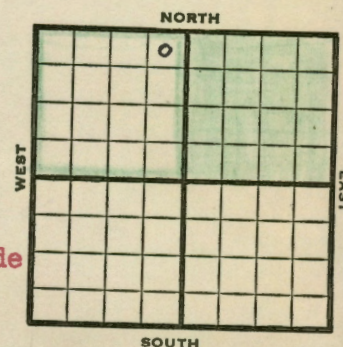

1950


Elev. 2055'

REPORT

11/15	To start drilling not later than Dec. 1, 1950.	
11/21	168' of surface casing set .	(Card)
11/22	Drilling 550'.	"
11/24	Drilling 2240'.	"
11/25	Drilling 2525'.	"
11/26	Drilling 2750'.	"
11/27	Drilling 2939'.	"
11/28	Drilling 3165'.	"
11/29	Drilling 3330'.	"
11/30	DST. 3338'- 82'	
	Open 30 mins.	
	Rec. 90' mud	
	180' salt water	
	Drilling ahead.	"
12/1	TD. 3505'	
	Schl. run at 3505', there have been no shows, well will be abandoned at this point.	"
12/6	Spud 11-20-50	
	D&A TD 3505'	
	8-5/8" @ 120' Lans. 3334'	
	Heeb 3300' odr & oil stn 3353-56	
	DST 3338-82 opn 1/2 hr. Rec. 90' mud	
	180' sw TD 3505' D&A	


ABANDONED

County Phillips State Kansas
 Sec. 2 (Blk. 1 (Sur. 18W Map No.
 (Twp.) (Rge.)
 Operator Stableford & K & E Drlg.
 Well No. 1 Farm Caswell
 Elev. _____ Location NE NE NW
 330 Ft. From N Line NW
 330 Ft. From E Line Quarter
 1st. Report NOV 22 1950
 Completion _____
 Remarks MCPC farmout
Lans. test
K & E Drlg. - Contr.
 Spudding Date 11-20-50
 Drig. Data Wildcat
8 5/8" @ 120 drlg. 550

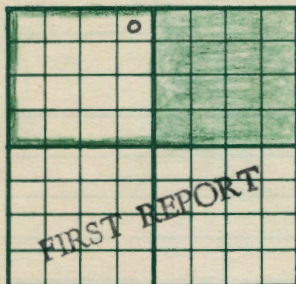

J. E. TYRA

County Phillips State Kansas
 Sec. 2 (Blk. 1 (Sur. 18W Map No.
 (Twp.) (Rge.)
 Operator Stableford & K & E Drlg.
 Well No. 1 Farm Caswell
 Elev. 2055 Location NE NE NW
 330 Ft. From N Line NW
 330 Ft. From E Line Quarter
 1st. Report _____
 Completion DEC 6 1950
 Remarks Wildcat
K & E Drlg. - Contr.
 Spudding Date 11-20-50
 Drig. Data D & A TD 3505
8 5/8" @ 120 Lans. 3334 Heeb. 3300
odor & oil stain 3353-56 DST 3338-82
open 1/2 hr. Rec. 90' mud 180' sw TD 3505

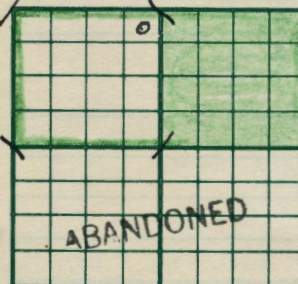

J. E. TYRA

Date: Nov. 24, 1950

Dear Sir:

Today's 8:00 A.M. drilling depth on the Caswell #1, NE NE NW Sec. 2-18-18W, Phillips County, Kansas is 2240 feet.

K & E Drilling, Inc.

By Due Pearl

November 22, 1950

Dear Sir:

168' of surface casing was set on the Caswell #1, NE NE NW Sec. 2-18-18W, Phillips Co., Kansas, at 3:30 A.M., November 21, 1950. Drlg. depth at 8:00 A.M., November 22, 550'.

You will be sent a card daily listing the drilling depth at 8:00 A.M. of that day.

K & E Drilling, Inc.

By Due Pearl

Date 11/26/50

Dear Sir:

Today's 8:00 A.M. drilling depth on the Caswell #1, NE NE NW Sec. 2-18-18W, Phillips County, Kansas is 2750 feet.

K & E Drilling, Inc.

By Due Pearl

Date: 11/25/50

Dear Sir:

Today's 8:00 A.M. drilling depth on the Caswell #1, NE NE NW Sec. 2-18-18W, Phillips County, Kansas is 2525 feet.

K & E Drilling, Inc.

By Due Pearl

Date: 11-28-50

Dear Sir:

Today's 8:00 A.M. drilling depth on the Caswell #1, NE NE NW Sec. 2-18-18W, Phillips County, Kansas is 3165 feet.

K & E Drilling, Inc.

By Due Pearl

Date 11/27/50

Dear Sir:

Today's 8:00 A.M. drilling depth on the Caswell #1, NE NE NW Sec. 2-18-18W, Phillips County, Kansas is 2939 feet.

K & E DRILLING, INC.

BY Due Pearl

Date: 11-30-50

Dear Sir:

Today's 8:00 A.M. drilling depth on the Caswell #1, NE NE NW Sec. 2-18-18W, Phillips County, Kansas is _____ feet.

K & E DRILLING, INC.

P.S. D.S.T. run 3338-82', open 30 min., recovered 90' mud, 180' salt water, drilling ahead. BY Due Pearl

Date 11-29-50

Dear Sir:

Today's 8:00 A.M. drilling depth on the Caswell #1, NE NE NW Sec. 2-18-18W, Phillips County, Kansas is 3330 feet.

K & E DRILLING, INC.

BY Due Pearl

Date 12-1-50

Dear Sir:

Today's 8:00 A.M. drilling depth on the Caswell #1, NE NE NW Sec. 2-18-18W, Phillips County, Kansas is 3505 feet.

K & E DRILLING, INC.

Slumberger run at 3505'- there have been no shows-BY Due Pearl well will be abandoned at this point.



THIS SIDE OF CARD IS FOR ADDRESS



Sam Baird
Box 381
Tulsa 2, Oklahoma




THIS SIDE OF CARD IS FOR ADDRESS



Mr. H. B. Key
Land Department
Mid Continent Petroleum Corp.
Tulsa 2, Oklahoma



THIS SIDE OF CARD IS FOR ADDRESS

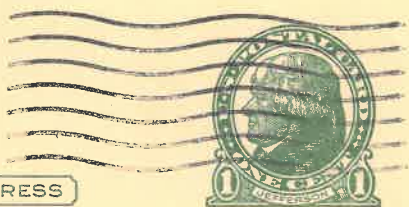

Sam Baird
Box 381
Tulsa 2, Oklahoma



THIS SIDE OF CARD IS FOR ADDRESS



Sam Baird
Box 381
Tulsa 2, Oklahoma



THIS SIDE OF CARD IS FOR ADDRESS




Sam Baird, Chief Scout
Box 381
Tulsa 2, Oklahoma



THIS SIDE OF CARD IS FOR ADDRESS



Sam Baird, Chief Scout
Box 381
Tulsa 2, Oklahoma

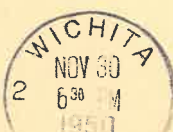

THIS SIDE OF CARD IS FOR ADDRESS



Sam Baird, Chief Scout
Box 381
Tulsa 2, Oklahoma



THIS SIDE OF CARD IS FOR ADDRESS



Sam Baird, Chief Scout
Box 381
Tulsa 2, Oklahoma



THIS SIDE OF CARD IS FOR ADDRESS



Sam Baird, Chief Scout
Box 381
Tulsa 2, Oklahoma