


Phillips

KANSAS

SECTION 16 TOWNSHIP 1S RANGE 18W

WELL NO. #2 Stahn "A"

COMPANY Livingston Oil (Tulsa)

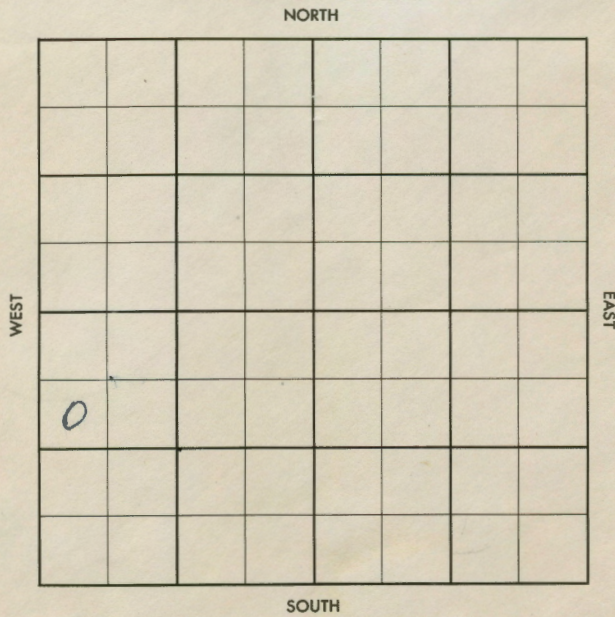

12

County Phillips Elev. _____
 Sec. 16 Twp. 1S Rge. 18W
 Company Livingston Oil (Tulsa)
 FarmName Stahn "A" No. 2

TOPS	DEPTH	LOG	DATUM	Loc. in Sec.
Anh.				SW NW SW
Tr.				
H.				
Tr.				
Dg.				
Bl.				
L.				Geo. <u>Aukerman</u>
K.C.				Contr.
B.K.C.				
Ce.				<u>Lewis Drlg</u>
C.				<u>rig #1</u>
M.				Pool
M.				<u>Huffstutter</u>
K.				
Mz.				
Me.				
V.				
S.				
S.				
A.				
R.				
Pe.				
G.				
T.D.				

FIRST REPORT
 OCT 3 '56

Date Comm. 9-28-56
8" 2 1/4 w/155 sx; D 1230

(Faint red stamp: 8207 1 100)

(Faint red stamp: G.H.)

Co.
 Sec.
 No.
 Sec.
 T.
 R.

County Phillips Elev. 2146 KB
 Sec. 16 Twp. 1S Rge. 18W
 Company Livingston Oil (Tulsa)
 Farm Name Stahn "A" No. 2

TOPS	DEPTH	LOG	DATUM	Loc. in Sec.
Anh.	69			SW NW SW
Tr.	3080			
H.	3292			
Dg.	lotan	3321		
Bl.				
L.	-KC	3328		Geol. <u>Aukerman</u>
K.C.				Contr. <u>Lewis Drlg</u>
B.K.C.				<u>Fig #1</u>
Ce.				Pool <u>Buffstutter</u>
C.				
M.				
M.				
K.				
Mz.				
Me.				
V.				
S.				
S.				
A.				
R.				
PE.				
G.				
TD.	3467			

COMPLETE
 NOV 7 '56

Date Comm. 9-28-56
8" 2U. w/155 ex; D 1230 OCT 10 '56 sch.
Taps Tr 3080 Hh 3292 lotan
or Lsg-KC 3321 True Lsg 3328
DST 3326-45 or 1hr. rel. 10' Md
All press 0 DST 3353-75 or 1hr
rel. 60' OCM 1DHP 955 FDHP
930/20" FP 0-25 DST 3393
-3415 or 1hr. rel. 110' VHDGM
+90' gas 1BHP 1185 FDHP 1120/20
FP 0-55 RA9 5/2 @ 3466 OCT 17 '56

5/2 @ 3466 CO 3460 GRNK
20/3406-11 not st nat. 1 1/2' @ SW
~~11 3/4~~ 59d PF. CO 3400
20/3387-92" 11 23 60+ Tr wtr
11 3 hrs 11 @ 71.25 B oil no/w
11 8 hrs 20/3372-77 11 OCT 24 '56
Plg ahead of PF. 5' @ 3382 1 1/2' @
12 Boph no/w 10 hrs CO 3400
@ 40 B0 no/w 2 hrs T S R .OCT 31
X WO Pump unit NOV 7 '56 P 60
Boph no/w tr. 9 hrs 38'

16-1-18 sw near sw