


Phillips

KANSAS

SECTION 17 TOWNSHIP 1 RANGE 18W

WELL NO. #1 Lutjeharms

COMPANY Livingston Oil Co.

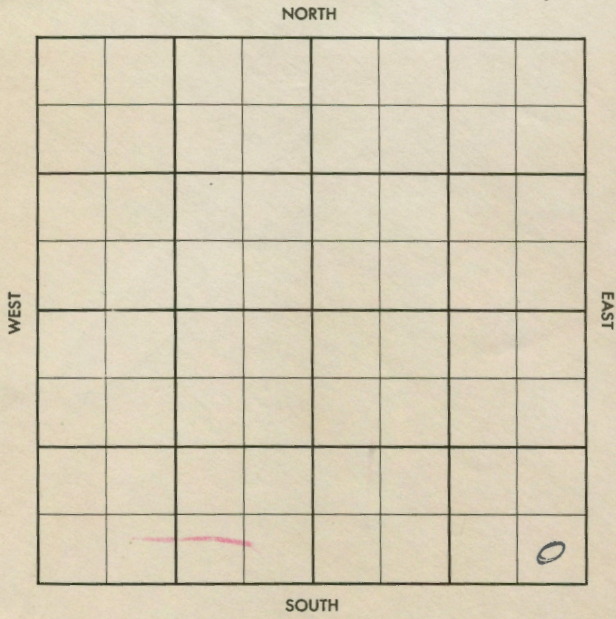

16

County Phillips Elev. _____
 Sec. 17 Twp. 1 Rge. 18W
 Company Livingston Oil Co.
 Farm Name Lutjeharms No. 1

TOPS	DEPTH	LOG	DATUM	Loc. in Sec.
Anh.				SE SE SE
TP.				
H.				
Tr.				
Dg.				
Bl.				
L.				Geol.
K.C.				Contr.
B.K.C.				
Ce.				Lewis Tools
C.				
M.				Pool
M.				
K.				Huffstutter
Mz.				
Ma.				
V.				
S.				
S.				
A.				
R.				
Pe.				
G.				
TD				

OCT 17 '56
 FIRST REPORT
 No. 0

Date Comm. spd. 10-12-56
8" @ 207, Drlg. 2000

8281 1 E 100
R.O.

Co.
 Lgs.
 No.
 Sec.
 T.
 R.

County Phillips Elev. 2126 KB
 Sec. 17 Twp. 1 Rge. 18W
 Company Livingston Oil Co.
 Farm Name Lutjeharms No. 1

TOPS	DEPTH	LOG	DATUM	Loc. in Sec.
Ans.				SE SE SE
Tr.	3054	3054		
H.		3268		
Tr. <u>lotan</u>		3297		
Dg.				
BL.				
L.		3314		Geol.
K.C.				Contr.
B.K.C.				Lewis Tools
Ce.				Pool
C.				Huffstutter
M.				
W.				
K.				
Mr.				
Me.				
V.				
S.				
S.				
A.				
R.				
PE.				
G.				
TD	3393			

COMPLETE
 NOV 15 '56

Date Comm. spd. 10-12-56

8" @ 207, Drlg. 2000 OCT 24 '56 Elev.

Log Tops - Tp. 3054 Hb 3268 lotan or
 Lsg-Kc 3297 Lsg 3314 DST ~~3332~~ -50
 3302-22 op lhw rec 17' Md All press
 o DST 3332-50 op lhw rec 27' OCM
 1BHP 850/20 FBHP 550/20 Building
 DST 3371-93 op lhw rec 69' VHO CM
 FP 35-50 1BHP 1140 FBHP 1105
 120" RTD 3393 5 1/2 @ 3393/100 WOC
 Rig stacked (another log?) OCT 31 '56

X co 3390 20/3382-87 @ 2.60
 no/w lhw N \$ 4 Boph no/w tr
 no time PB 3372 24/3362-68
 @ 1.30 no/w lhw N \$ 15 Boph
 no/w no time PB 3360 16/3345
 -55 tst 8 60. no/w lhw N
 \$ 4 Boph no/w tr no time co
 to 3390 to tst All PFS. NOV 7 '56
 \$ 24 Bop no/w 5 hrs
 wo pump NOV 13 '56 P. 50 Bopd
 no/w tr 24 hrs

M-1-18

se se se